ZONING INFORMATION BLOCK: R 5- SINGLE FAMILY RESIDENTIAL CLASSIFICATION: SEE CIVIL ENGINEER DRAWINGS FOR ZONING INFORMATION 39,624 CU. FT NEW VOLUME EXISTING TOTAL

1,200.8 SF

1,790.2 SF

DOOR SYMBOL

1,689.4 SF

1,384.1 SF

488.6 S

794.7 SF

1,283.3 SF

DRAWING	SYMBOLS	
DRAWING TAGS		
X A-X	ELEVATION REFERENCE DRAWIN	NG NUMBER
X A-X	SECTION REFERENCE DRAWIN	NG NUMBER
A-X	DETAIL REFERENCE DRAWIN	NG NUMBER
WALL TYPES		PLAN SYMBOLS
BRICK VEN	TO BE REMOVED CONSTRUCTION EER	STRUCTURAL POST POST ABOVE NEW BEAM REVISION TAG WINDOW SYMBOL
CONCRETE	BLOCK	# DOOR SYMBOL

ABBREVIATIONS:

SECOND FLOOR

* DENOTES EXISTING NON-CONFORMING

** DENOTES VARIANCE REQUIRED

FIRST FLOOR

BB	=	BASE BOARD	MS	=	MOTION SENSOR
					NOT TO SCALE
BBH	=	BASEBOARD HEAT	NTS	=	
CAB.	=	CABINET	PREFAB.	=	PREFABRICATED
CH	=	COUNTER HEIGHT	PSF	=	POUNDS PER SQUARE FOOT
CL	=	CENTER LINE	RAD.	=	RADIATOR
CLST	=	CLOSET	REF.	=	REFRIGERATOR
CMD		= CARBON MONOXIDE	R.O.	=	ROUGH OPENING
DETECTO	OR		SD	=	SMOKE DETECTOR
D.J.	=	DOUBLE JOIST	SH	=	SHOWER HEAD
DL	=	DAMP LOCATION	SPECS.	=	SPECIFICATIONS
D.O.	=	DOUBLE OVEN	TB	=	TOWEL BAR
D.W.	=	DISHWASHER	TP	=	TOILET PAPER HOLDER
ELEV.		= ELEVATION	TR	=	TOWEL RING
EX'G	=	EXISTING	T.O.	=	TRIMMED OPENING
FURN.	=	FURNACE	U.C.	=	UNDER COUNTER
GFI	=	GROUND FAULT INTERRUPT	VTR	=	VENT THROUGH ROOF
G.D.	=	GARBAGE DISPOSAL	WP	=	WATER PROOF
HWH		= HOT WATER HEATER			
LIN.	=	LINEN			

SITE PLAN NOTES:

MICRO. = MICROWAVE

= MEDICINE CABINET

1. INFORMATION FOR THIS SITE PLAN TAKEN FROM SURVEY DATED

SHEAR WALL. SEE SHEAR NOTES

PAGE- MUELLER ENGINEERING CONSULTANTS, PC CATHERINE A. MUELLER, P.E. #GE44252 P.O. BOX 4619 WARREN, NEW JERSEY 07059 TEL.: 732-805-3979 FAX: 732-805-3978


SITE WORK NOTES:

- 1. ALL TREE REMOVAL BY OTHERS. REMOVAL OF STUMPS IN THE AREA OF THE FOUNDATION SHALL BE BY
- 2. SEPARATE CONTRACT SHALL BE TAKEN FOR THE DRIVEWAY AND CURBING, PATIO, WALKWAYS AND RETAINING WALLS.
- 3. THE PLATFORMS, WINDOW WELLS, A/C CONDENSERS & PAD, AND EXTERIOR BASEMENT STAIR SHALL BE PROVIDED BY THE GENERAL CONTRACTOR.
- 4. ALL NEW STORMWATER MANAGEMENT DRYWELLS AND PIPING, ETC ON THE CIVIL ENGINEERING DRAWINGS SHALL BE DONE BY THE GENERAL CONTRACTOR.
- 5. REFER TO CIVIL ENGINEERING DRAWINGS FOR ADDITIONAL INFORMATION.

ADDITION & ALTERATIONS FOR

JOHNSON/ZIMMERMAN RESIDENCE

54 MYRTLE AVENUE, METUCHEN, NJ

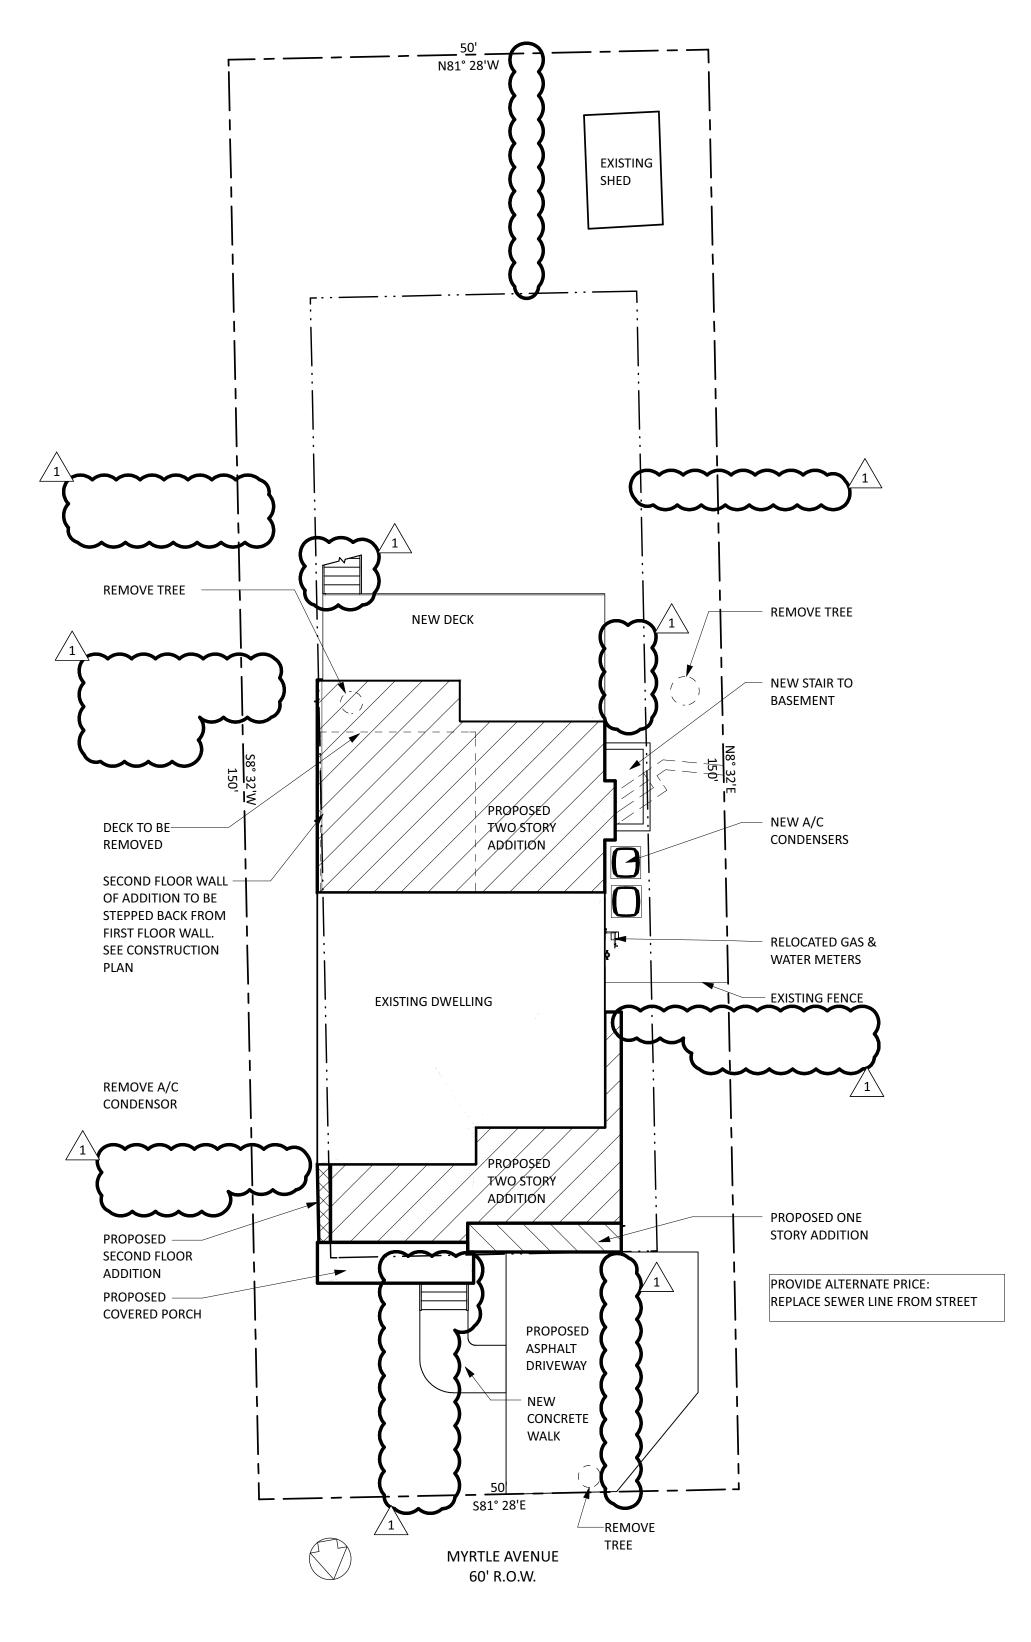

	DRAWING LIST
DWG	TITLE
A-1	GENERAL NOTES. SYMBOLS. SITE PLAN. ZONING CHART
A-2	BASEMENT/ FOUNDATION, FIRST & SECOD FLOOR DEMOLITION PLANS, NOTES
A-3	FOUNDATION/ BASEMENT & FIRST FLOOR CONSTRUCTION PLANS. NOTES
A-4	SECOND FLOOR CONSTRUCTION PLAN, NOTES
A-5	ATTIC & ROOF PLAN
A-6	PLUMBING RISER, WATER RISER & GAS RISER DIAGRAMS, DOOR & WINDOW SCHEDULES
A-7	EXTERIOR ELEVATIONS. NOTES
A-8	EXTERIOR ELEVATIONS
A-9	WALL SECTION, DETAILS, NAILING SCHEDULE
A-10	BASEMENT/ FOUNDATION ELECTRICAL FLOOR PLAN. NOTES
A-11	FIRST, SECOND FLOOR & ATTIC ELECTRICAL PLANS
A-12	FOUNDATION DETAILS, FLITCH BEAM DETAILS, BUILDING SECTIONS

PROJECT TEAM:

54 MYRTLE AVENUE METUCHEN, NJ

ARCHITECT OF RECORD: THEODORA BOYADJIS DESIGNS, LLC THEODORA BOYADJIS, RA, LEED AP

CODE & REGULATIONS

NEW JERSEY ADMINISTRATIVE CODE SUBCODE 5:23-6 2014 INTERNATIONAL BUILDING CODE - NJ ED., 2018 INTERNATIONAL RESIDENTIAL CODE - NJ ED., 2018 NATIONAL ELECTRICAL CODE, 2017 NATIONAL STANDARD PLUMBING CODE, 2018 INTERNATIONAL MECHANICAL CODE, 2018 INTERNATIONAL ENERGY CONSERVATION CODE - NJ ED., 2018 INTERNATIONAL FUEL GAS CODE, 2018

PROJECT DESCRIPTION:

CONVERT A CAPE COD STYLE HOUSE TO A TWO STORY STYLE HOUSE. CONVERSION INCLUDES A FULL SECOND STORY ADDITION OVER THE FIRST FLOOR FOOTPRINT AND A TWO STORY ADDITION AT THE REAR AND SIDES. FIRST FLOOR TO INCLUDE A RENOVATED KITCHEN, NEW FAMILY ROOM, NEW GARAGE AND RENOVATED DINING ROOM. SECOND FLOOR TO INCLUDE A NEW MASTER SUITE, TWO BEDROOMS AND A

GENERAL NOTES:


- 1. ALL WORK IS TO CONFORM TO ALL APPLICABLE REQUIREMENTS OF ALL GOVERNING LOCAL, STATE AND FEDERAL CODES, LAWS, REGULATIONS, AND BEST TRADE PRACTICES.
- 2. THE CONTRACTOR SHALL GIVE ALL NOTICES, OBTAIN ALL PERMITS, LICENSES, CERTIFICATES OF INSPECTION, OF APPROVAL, OF OCCUPANCY AND OTHER SUCH INSTRUMENTS REQUIRED FOR HIS WORK, AND PAY ALL COSTS AND FEES FOR THEM. THE CONTRACTOR SHALL MAKE ALL NECESSARY ARRANGEMENTS FOR THE CONNECTIONS OF UTILITIES AND PAY THE CHARGES FOR
- 3. EXCEPT AS OTHERWISE NOTED, THE CONTRACTOR SHALL GUARANTEE ALL WORK AGAINST DEFECTS FOR ONE (1) YEAR FROM THE DATE OF SUBSTANTIAL COMPLETION. THE NECESSARY REPAIRS OR CHANGES SHALL INCLUDE CORRECTING ANY DEFECTIVE OR INFERIOR WORK AND CORRECTING ALL DAMAGE TO PROPERTY CAUSED BY SUCH WORK OR BY CORRECTING IT.
- 4. ALL DIMENSIONS AND CONDITIONS SHOWN AND ASSUMED ON THE DOCUMENTS MUST BE VERIFIED AT THE SITE BY THE CONTRACTOR BEFORE ORDERING ANY MATERIAL OR DOING ANY WORK. ANY DISCREPANCIES OR ERRORS IN THE DOCUMENTS MUST BE REPORTED TO THE ARCHITECT, AT ONCE. NO CHANGE IN PLANS, DETAILS, OR DIMENSIONS IS PERMISSIBLE WITHOUT THE CONSENT OF THE ARCHITECT.
- 5. MINOR DETAILS NOT USUALLY SHOWN OR SPECIFIED BUT NECESSARY FOR PROPER AND ACCEPTABLE CONSTRUCTION INSTALLATION, OR OPERATION OF ANY PART OF THE WORK, AS DETERMINED BY THE ARCHITECT, STANDARDS OF GOOD WORKMANSHIP AND BEST TRADE PRACTICES, SHALL BE INCLUDED IN THE WORK THE SAME AS IF HEREIN SPECIFIED OR INDICATED.
- 6. THE CONTRACTOR SHALL BE RESPONSIBLE FOR PROTECTION OF ALL EXISTING AND NEW CONDITIONS AND MATERIALS WITHIN AND ADJACENT TO THE CONSTRUCTION AREA. THE CONTRACTOR SHALL KEEP THE WORK SITE FREE FROM DEBRIS AND ACCUMULATED REFUSE, AND SHALL HAVE SOLE RESPONSIBILITY FOR PROTECTING ALL DANGEROUS AREAS FROM ENTRY BY UNAUTHORIZED PARTIES.
- 7. THE CONTRACTOR SHALL LAY OUT HIS WORK AND BE SOLELY RESPONSIBLE FOR ITS CORRECTNESS AND SAFETY, AND SHALL GIVE NECESSARY DIMENSIONS AND DIRECTIONS TO ALL
- 8. SUBSTITUTION OF EQUIPMENT OR MATERIALS OTHER THAN THOSE SHOWN IN THE DOCUMENTS SHALL BE MADE ONLY UPON THE APPROVAL OF THE ARCHITECT OR THE OWNER.
- 9. THE CONTRACTOR SHALL PATCH ALL AREAS WHICH ARE AFFECTED BY THE CONSTRUCTION TO MATCH THE EXISTING OR NEW ADJACENT MATERIALS AND SURFACES.
- 10. UPON COMPLETION OF THE WORK, THE ENTIRE PROJECT IS TO BE COMPLETELY CLEANED AND THE SITE RESTORED TO EXISTING CONDITION INCLUDING, BUT NOT LIMITED TO, THE
 - A. COMPLETE SWEEPING OF ALL AREAS, AND THE REMOVAL OF ALL RUBBISH AND DEBRIS B. REMOVAL OF ALL STAINS AND PAINT FROM GLASS, HARDWARE, FINISHED FLOORING, CABINETS, ETC.

FLOOR LOADS:

3.1. LIVE LOAD: 30 PSF 3.2. DEAD LOAD: 15 PSF

3.3. TOTAL: 45 PSF

1.1.	LIVE LOAD:	20 PSF	4.1.	LIVE LOAD:	40 PSF
1.2.	DEAD LOAD:	12 PSF	4.2.	DEAD LOAD:	15 PSF
1.3.	TOTAL:	32 PSF	4.3.	TOTAL:	55 PSF
2. ATTIC	::		5.DEC	CK:	
2.1.	LIVE LOAD:	20 PSF	5.1. I	LIVE LOAD:	60 PSF
2.2.	DEAD LOAD:	15 PSF	5.2. 1	DEAD LOAD:	15 PSF
2.3.	TOTAL:	35 PSF	5.3. ⁻	ΓΟΤΑL:	75 PSF

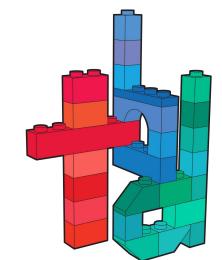

908.208.6085 299 barrow street #32 jersey city, nj 07302 theodorabdesigns.com

theodora boyadjis, RA, LEED AP NJ: 21AI01985000 NY: 039265

CONSULTANTS:

CLIENT MEETING 05.27.2021 **CLIENT MEETING ISSUE FOR BID CLIENT MEETING** 09.10.2021 **CLIENT REVIEW** 10.08.2021 PERMIT SET **ISSUE FOR PERMIT** 11.08.2021 **ISSUE FOR PERMIT** 01.28.2021 **ISSUE FOR PERMIT** REVISION 07.26.2022

REVISION JOHNSON/ZIMMERMAN RESIDENCE 54 MYRTLE AVENUE

METUCHEN NJ

GENERAL NOTES, SYMBOLS, SITE PLAN, ZONING CHART

DATE: 05.10.2021 DRAWN BY: SP SCALE: AS NOTED CHECKED BY: TB

COPYRIGHT 2021. theodora boyadjis designs, Ilc. ALL RIGHTS RESERVED. ALL DESIGNS AND CONCEPTS SHOWN ON DRAWINGS ARE PROPERTY LOCATION, COPIED, SOLD OR SHARED WITH ANY PERSONS, FIRMS OR CORPORATIONS WITHOUT EXPRESSED WRITTEN PERMISSION. PROJ. NO.: John21001 1 SHEET OF 12

DEMOLITION NOTES:

- 1. REMOVE ALL INTERIOR FINISHES, INCLUDING WOOD, PLASTER, GYPSUM BOARD, CERAMIC TILE, ETC. ON ALL WALLS INDICATED TO BE REMOVED.
- CONTRACTOR SHALL PROVIDE TEMPORARY STRUCTURAL SHORING AS REQUIRED TO COMPLETE THE WORK WITHOUT WEAKENING THE EXISTING BUILDING STRUCTURE.
- CONTRACTOR SHALL CONSULT WITH ARCHITECT SHOULD QUESTIONS ARISE REGARDING UNDERMINING THE EXISTING BUILDING STRUCTURE.
- 4. DISCONNECT PLUMBING, ELECTRICAL, AND DUCT WORK AS REQUIRED. CAP OFF UNUSED PLUMBING
- AND PROVIDE A RE-ROUTE FOR NEW WORK. 5. SPECIAL CARE SHALL BE TAKEN TO ENSURE THAT NO DAMAGE OCCUR IN ANY OTHER AREA OF THE
- BUILDING DURING DEMOLITION OF INDICATED AREAS. 6. SPECIAL CARE SHALL BE TAKEN TO PREVENT DIRT, DUST, AND CONSTRUCTION DEBRIS FROM
- ENTERING OTHER AREAS OF THE BUILDING. DOORS SHALL BE COVERED AND TAPED.

REMOVE ENTIRE SECOND FLOOR & ROOF

EXISTING BEDROOM

CH: 7'-11"

EXISTING STAIR AND SURROUNDING

WALLS TO REMAIN

- 7. THE WORK SHALL BE KEPT CLEAN ON A DAILY BASIS. ALL DEBRIS SHALL BE PUT IN A CONTAINER AT
- 8. CONTRACTOR SHALL CONSULT WITH OWNER/ TENANT PRIOR TO DISCARDING ANY EXISTING FIXTURES, HARDWARE, OR OTHER ITEMS THAT THE OWNER/ TENANT MAY WISH TO RE-USE.

SALVAGE NOTES:

CONSULT WITH OWNER FOR ITEMS TO BE SALVAGED:

- 1. WINDOWS
- 2. FRONT DOOR & HARDWARE
- DISHWASHER 4. REFRIGERATOR

SALVAGE TOILET & SINK FOR REUSE IN BASEMENT. SALVAGE SHOWERHEAD FOR REUSE IN 2ND FLOOR.

EXISTING BEDROOM

EX'G 2 X 8 @ 16" O.C.

ATTIC JOISTS

- 5. KITCHEN CABINETS 6. SECOND FLOOR BATHROOM FIXTURES
- 7. HOT WATER HEATER

908.208.6085 299 barrow street #32 jersey city, nj 07302 theodorabdesigns.com

theodora boyadjis, RA, LEED AP NJ: 21AI01985000 NY: 039265


CONSULTANTS:


CLIENT MEETING	05.27.2021
CLIENT MEETING	06.14.2021
ISSUE FOR BID	06.29.2021
CLIENT MEETING	09.10.2021
CLIENT REVIEW	10.08.2021
PERMIT SET	10.21.2021
ISSUE FOR PERMIT	11.08.2021
ISSUE FOR PERMIT	01.28.2021
REVISION	07.26.2022

REVISION JOHNSON/ZIMMERMAN RESIDENCE 54 MYRTLE AVENUE METUCHEN NJ

BASEMENT/ FOUNDATION, FIRST & SECOD FLOOR DEMOLITION PLANS, NOTES

DATE: 05.10.2021 DRAWN BY: SP SCALE: AS NOTED CHECKED BY: TB

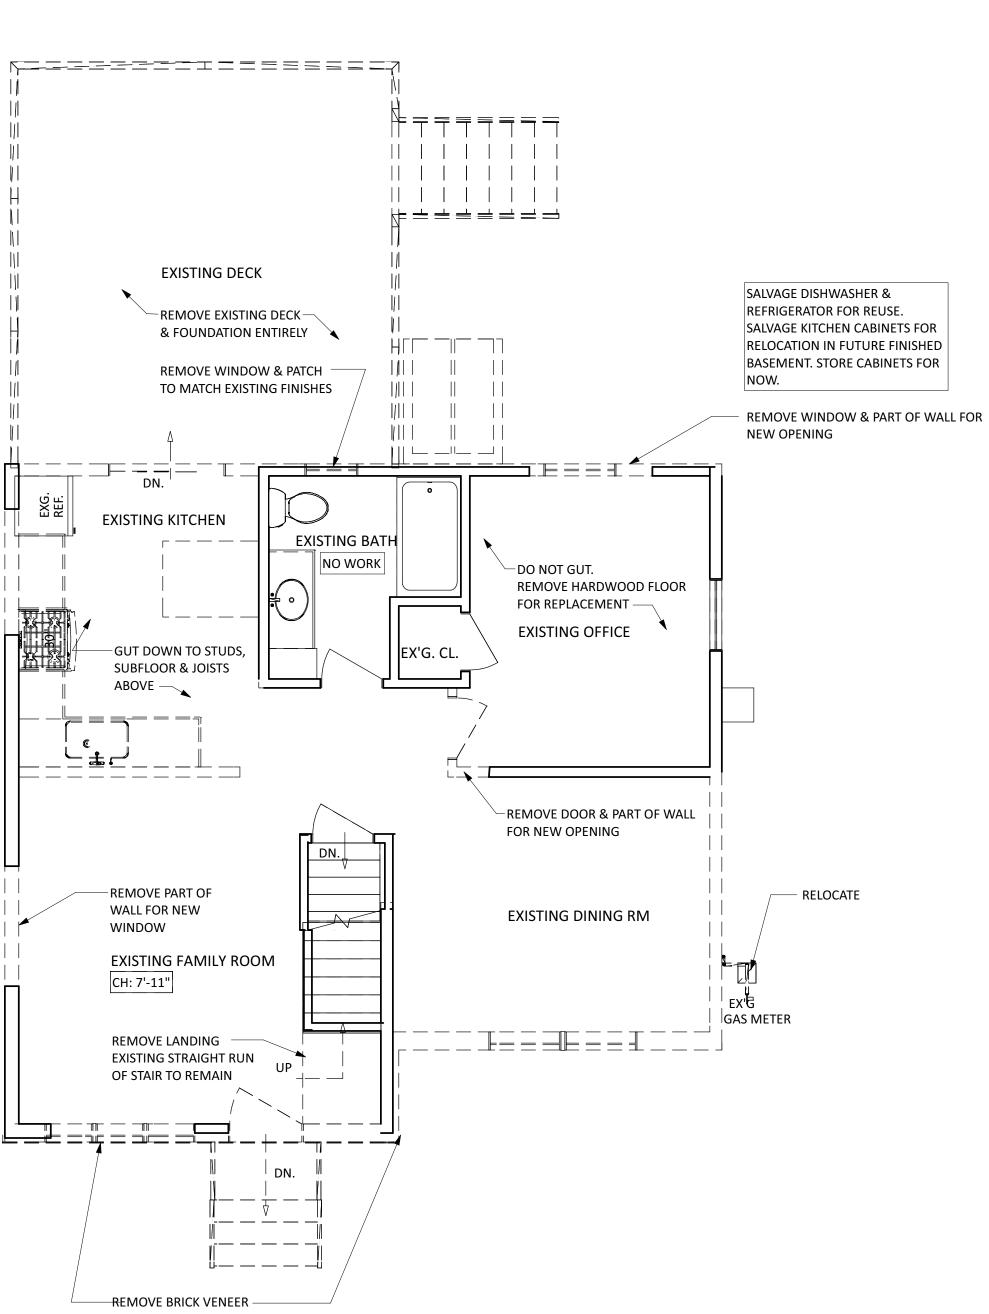

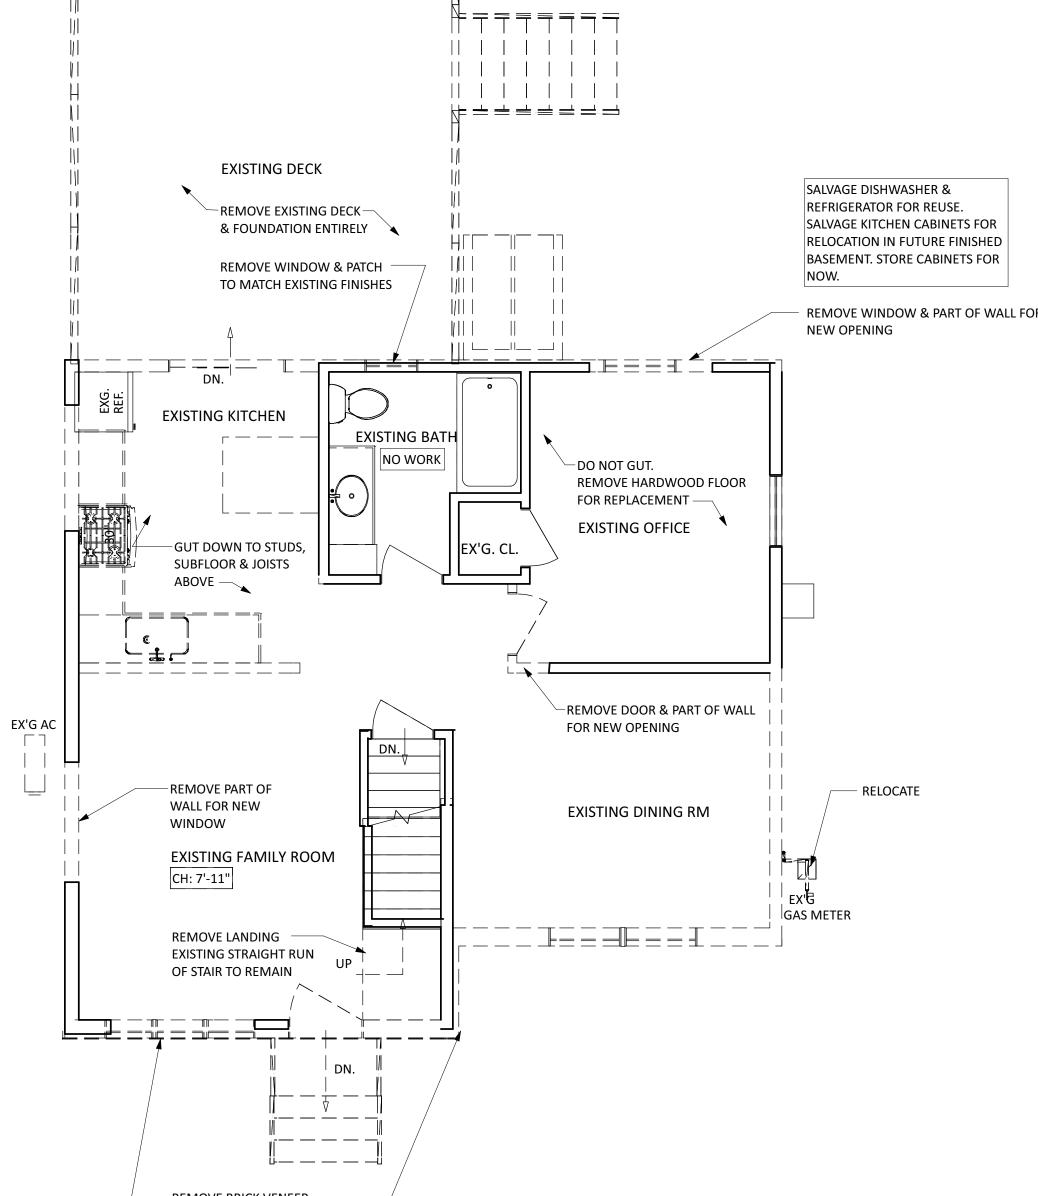

1 BASEMENT/ FOUNDATION DEMOLITION PLAN SCALE: 1/4" =1'-0"

_ — — — — — — — — — — — — — —

REMOVE DECK & STEPS

REMOVE FOR NEW OPENING

EXISTING UNFINISHED BASEMENT

EXISTING STAIR TO REMAIN

EX'G ELECTRICAL

PANEL

EX'G WASTE LINE

| | | | |

REMOVE STEPS TO GRADE ENTIRELY

-WASHER, DRYER & SINK TO

REMOVE HWH & BOILER

EX'G SUMP PUMP

REMOVE EXISTING BEAM & $^-$

COLUMN FOR NEW GARAGE

REROUTE PLUMBING IN -

RELOCATE EXISTING WATER —

REMOVE TOP COURSES OF — FOUNDATION WALL TO 6" BELOW BOTTOM OF NEW GARAGE SLAB

. _ _ ⊭ ≠ = = =

| | | - - - |

ENTIRELY

2 FIRST FLOOR DEMOLITION PLAN SCALE: 1/4" =1'-0"

3 SECOND FLOOR DEMOLITION PLAN SCALE: 1/4" =1'-0"


EX'G. CL.

EXISTING

ATTIC

2 X 4 RR

2 X 6 RR

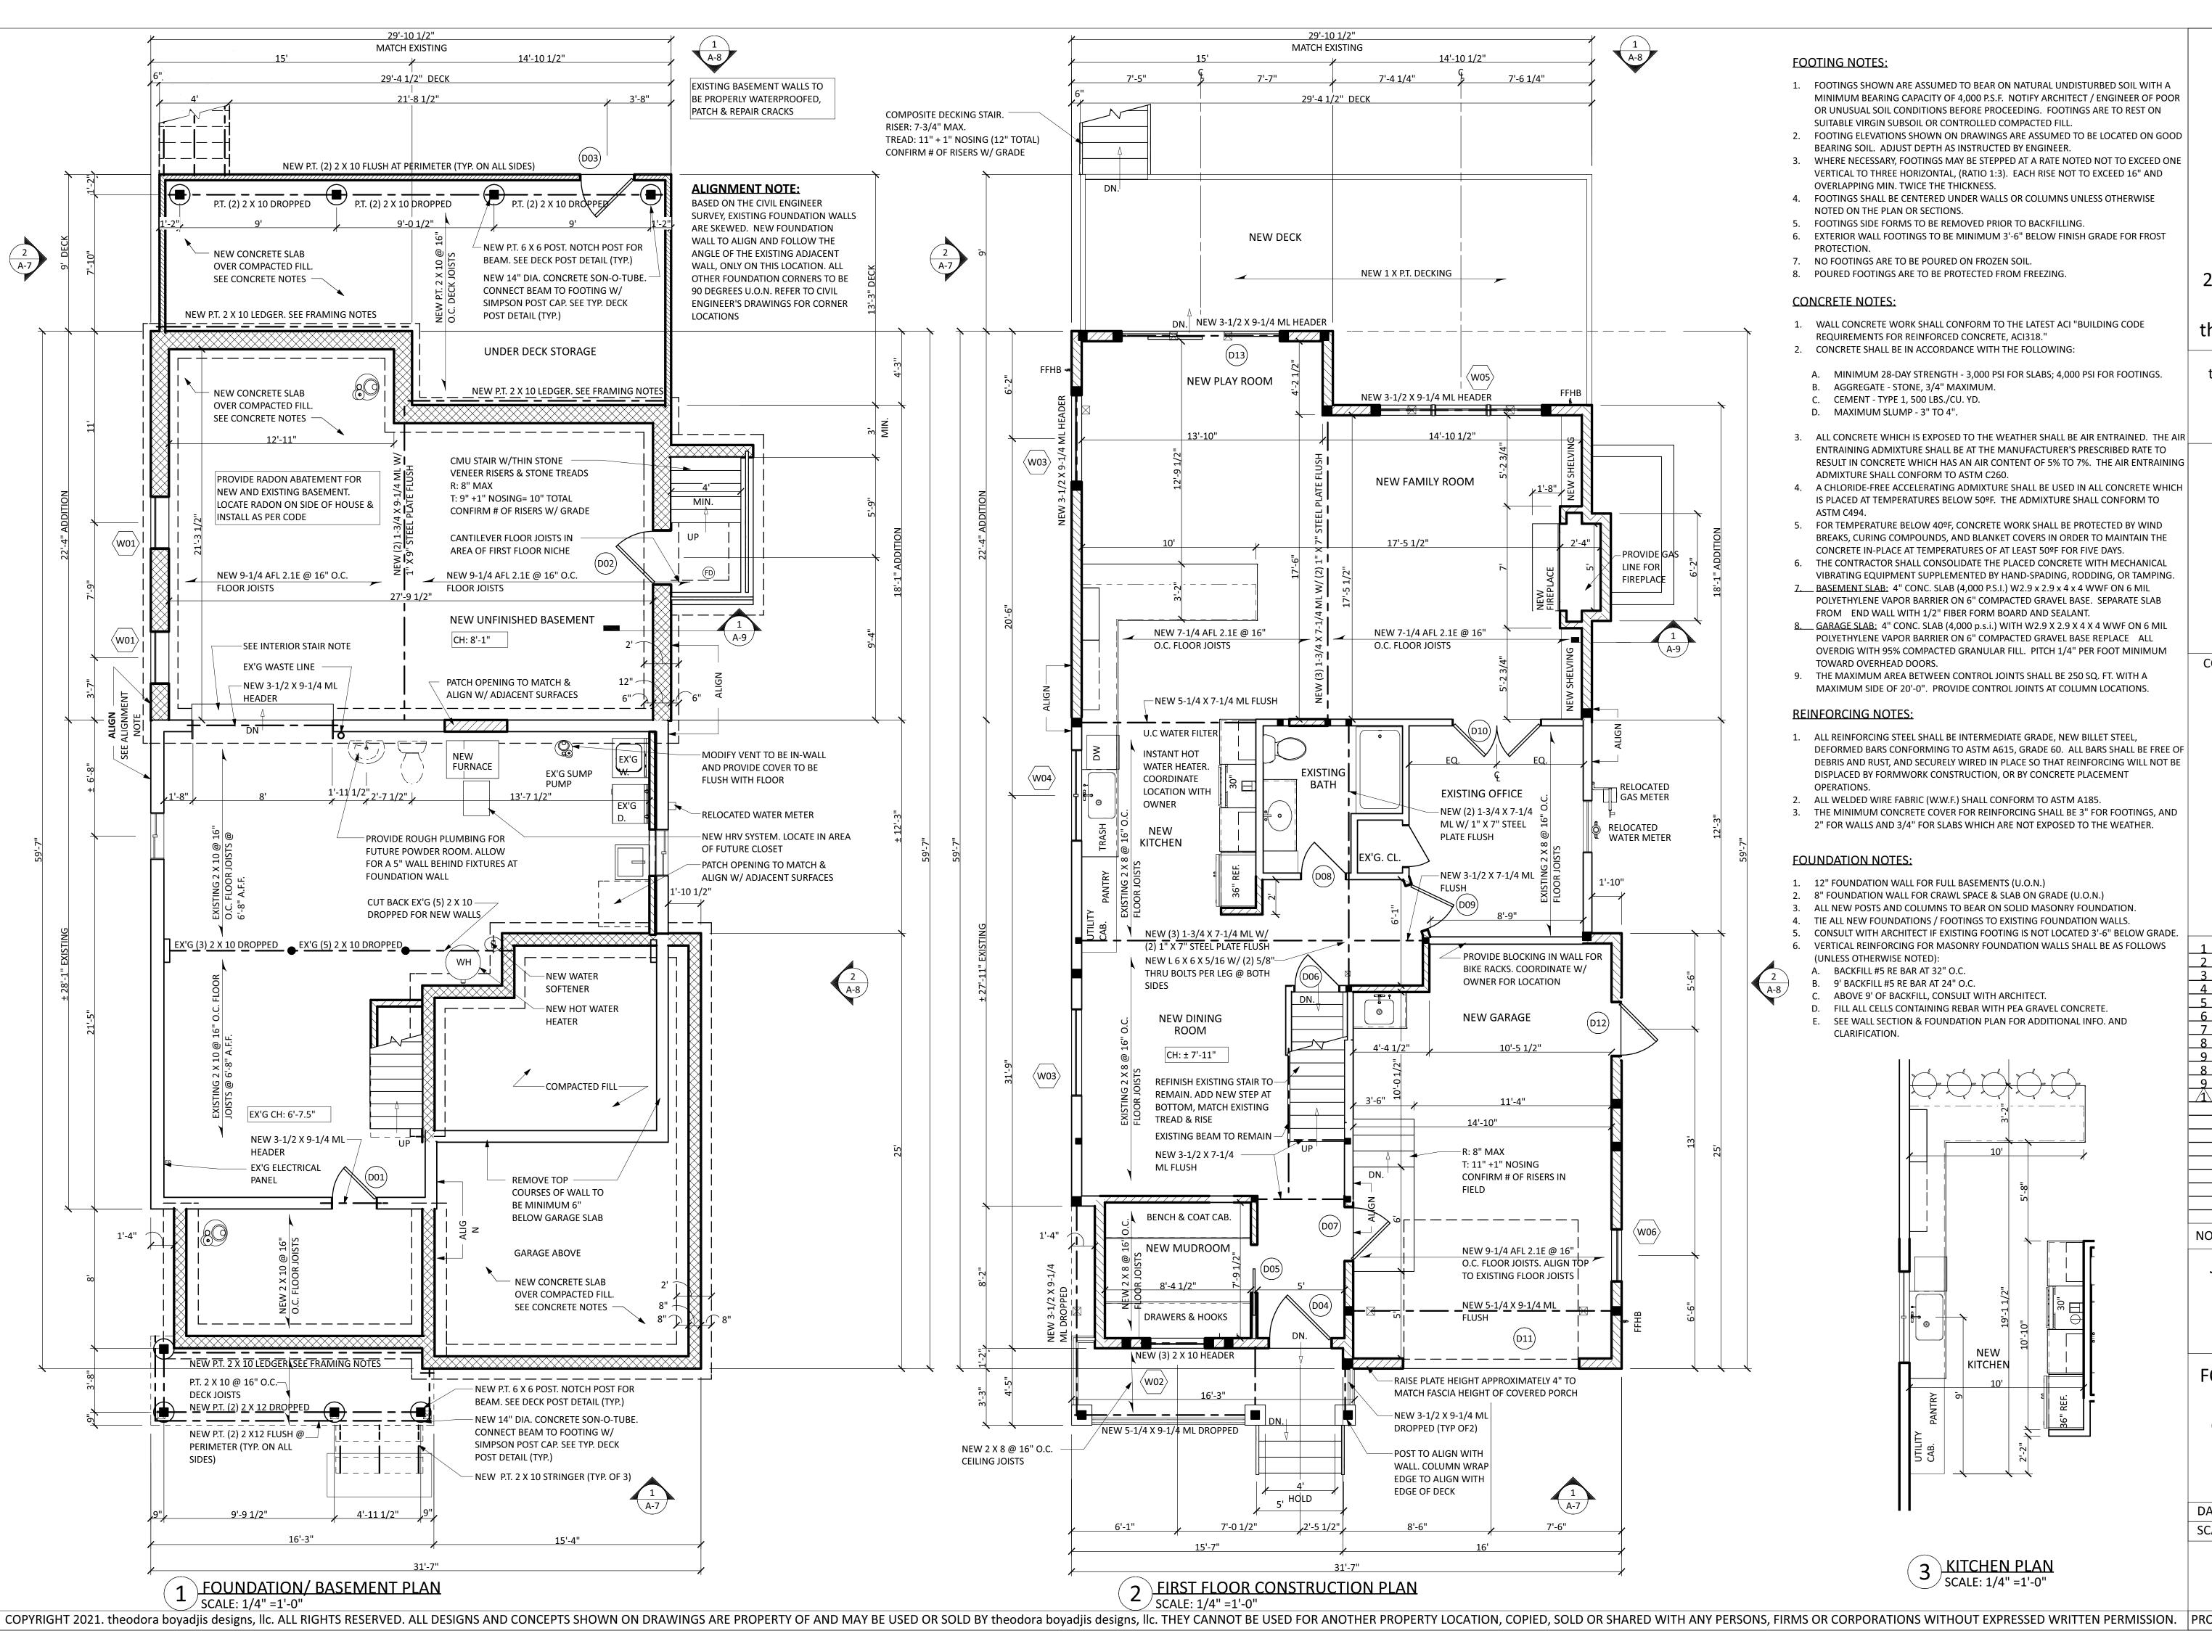

908.208.6085 299 barrow street #32 jersey city, nj 07302 theodorabdesigns.com

theodora boyadjis, RA, LEED AP NJ: 21AI01985000 NY: 039265

CONSULTANTS:

CLIENT MEETING 06.14.2021 **ISSUE FOR BID** 06.29.2021 **CLIENT MEETING** 09.10.2021 **CLIENT REVIEW** 10.08.202 PERMIT SET **ISSUE FOR PERMIT** 11.08.2021 **CLIENT REVIEW** CLIENT REVIEW 01.28.2021 **ISSUE FOR PERMIT ISSUE FOR PERMIT** REVISION **REVISION** JOHNSON/ZIMMERMAN

CLIENT MEETING

05.27.2021


METUCHEN NJ FOUNDATION/ BASEMENT & FIRST FLOOR

CONSTRUCTION PLANS, **NOTES**

RESIDENCE

54 MYRTLE AVENUE

DATE: 05.10.2021 DRAWN BY: SCALE: AS NOTED CHECKED BY:

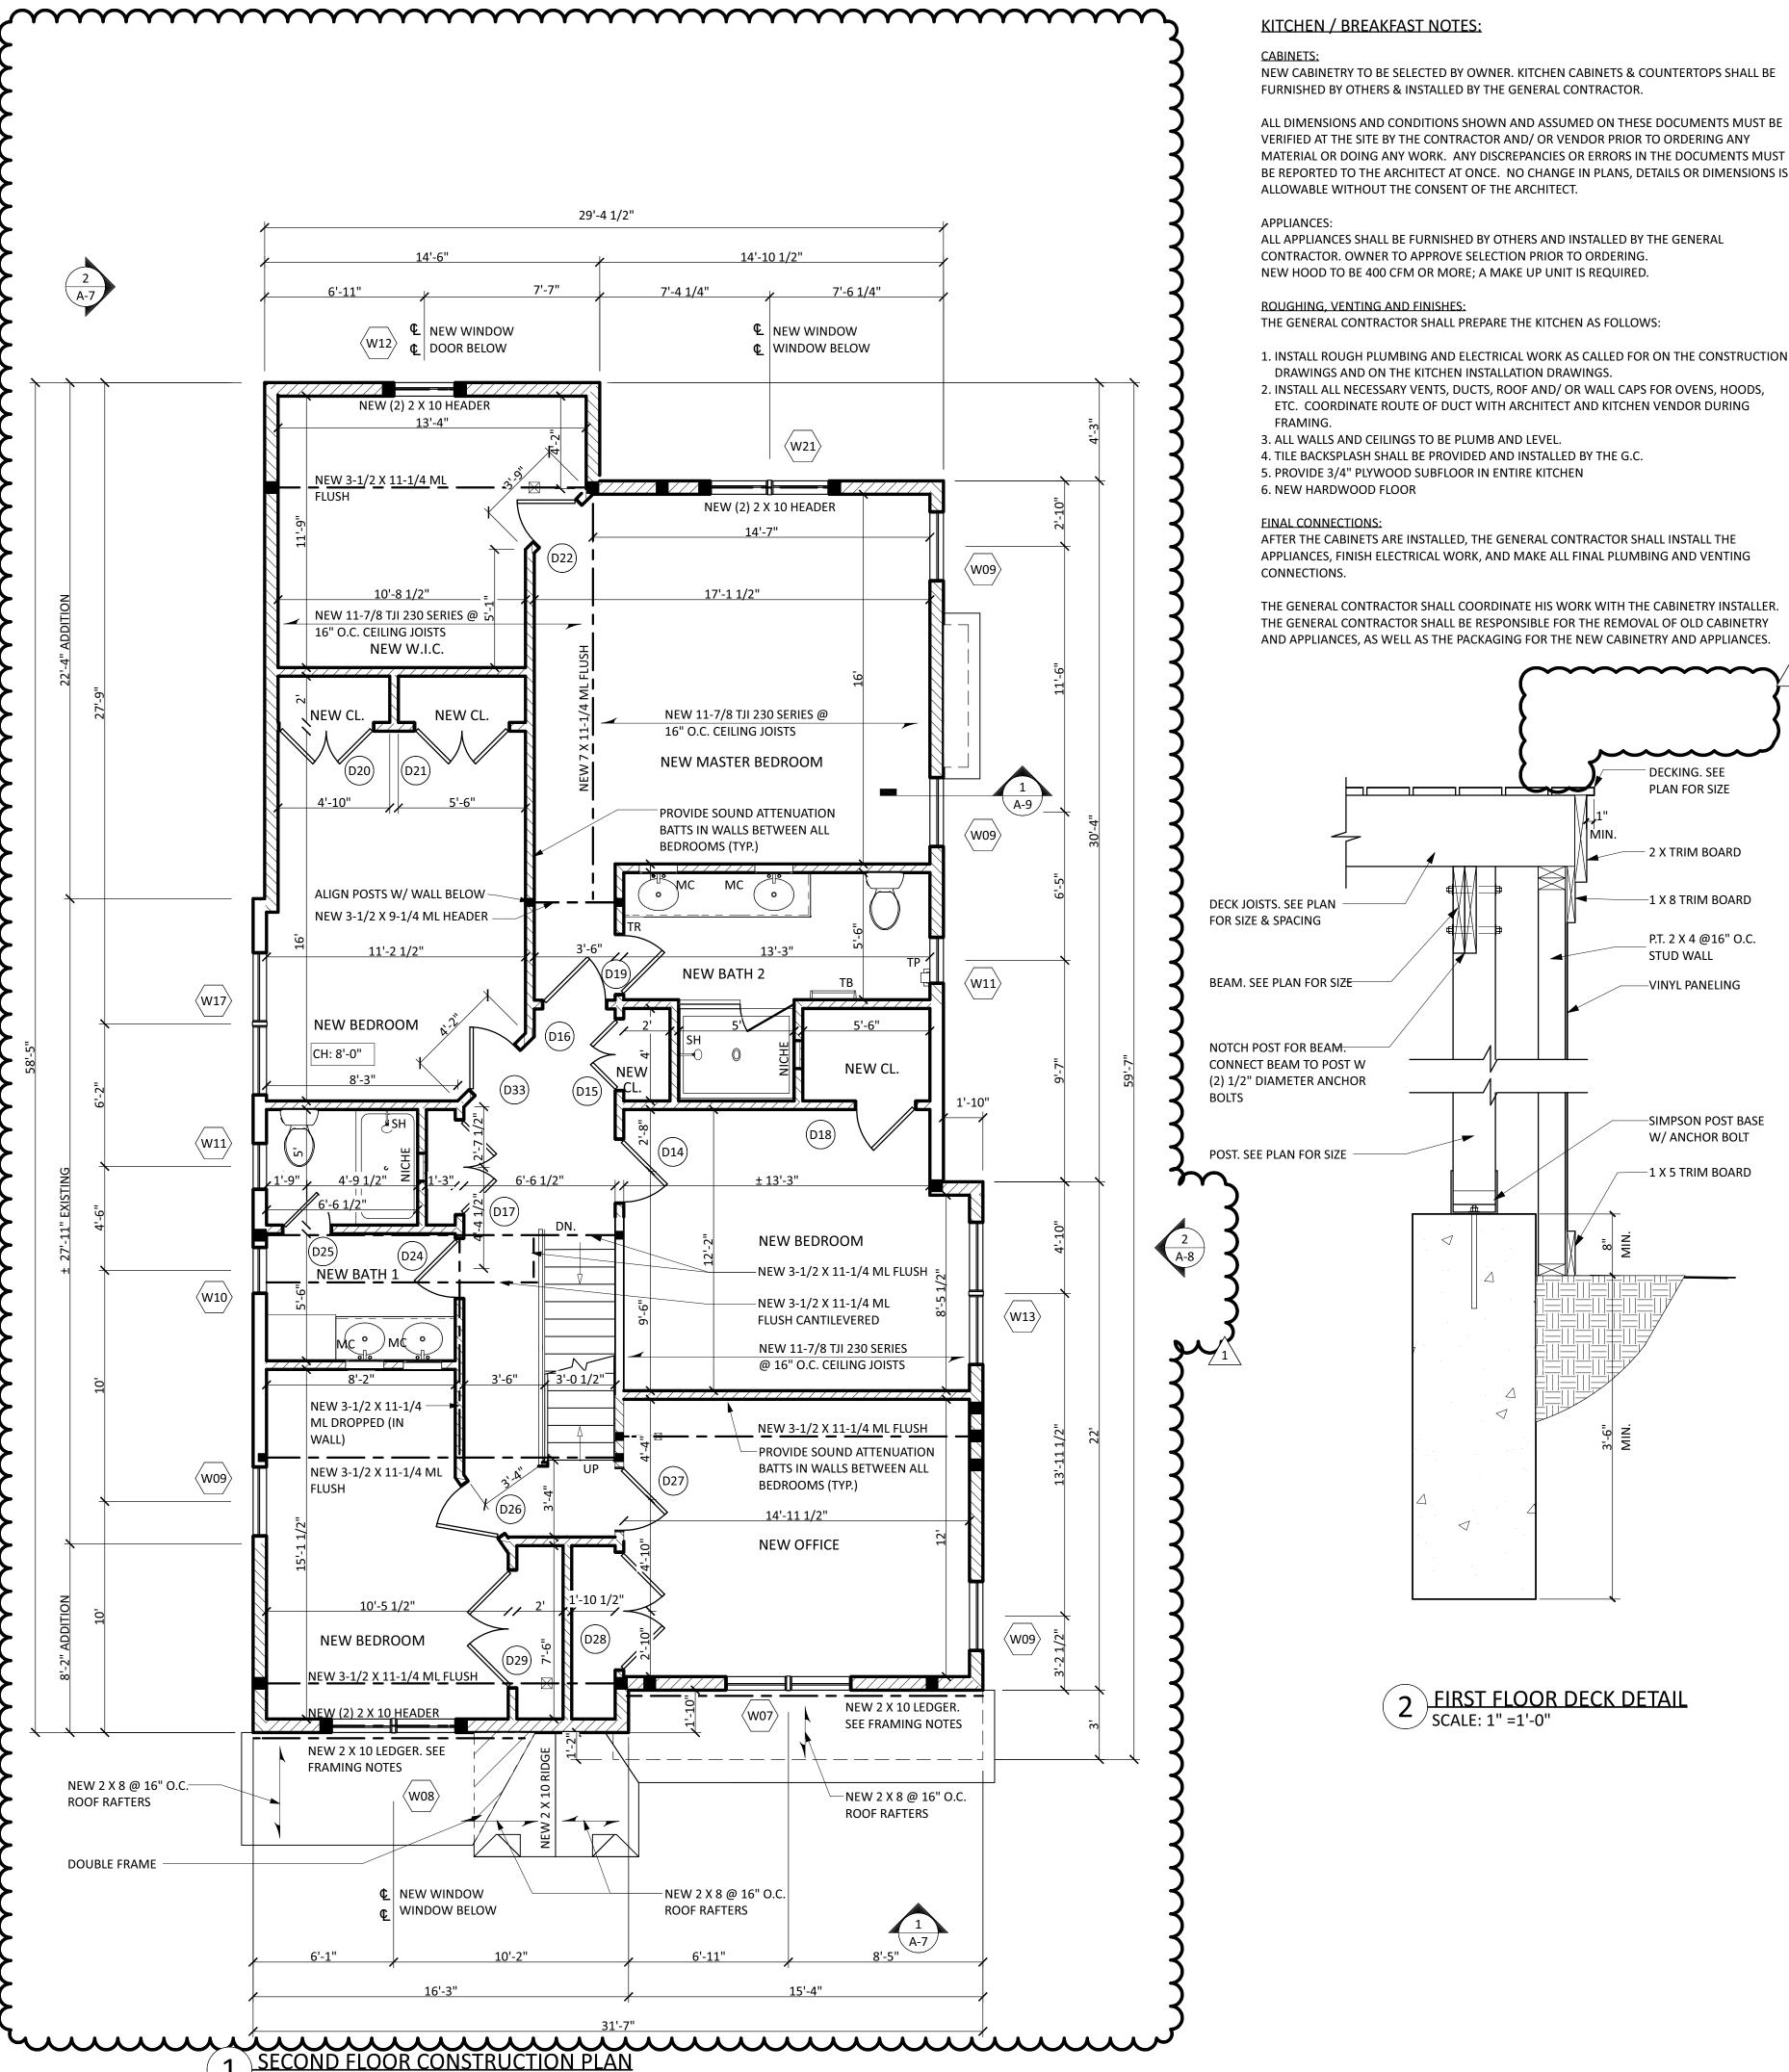

SCALE: 1/4" =1'-0"

PROJECT SPECIFICATIONS:

WINDOWS SHALL BE INSTALLED AS PER:

WITHIN 24" (610 MM) OF THE FINISHED FLOOR.

1. GLAZING IN FIXED AND OPERABLE DOORS

4. GLAZING IN GUARDRAILS AND RAILINGS

HORIZONTALLY FROM THE WATER'S EDGE.

TEMPERED GLAZING LOCATIONS:

R312.2 WINDOW SILLS. IN DWELLING UNITS, WHERE THE OPENING OF AN OPERABLE

WINDOW IS LOCATED MORE THAN 72 INCHES (1829 MM) ABOVE THE FINISHED GRADE OR

SURFACE BELOW, THE LOWEST PART OF THE CLEAR OPENING OF THE WINDOW SHALL BE A

MINIMUM OF 24 INCHES (610MM) ABOVE THE FINISH FLOOR OF THE ROOM IN WHICH THE

WINDOW IS LOCATED. OPERABLE SECTIONS OF WINDOWS SHALL NOT PERMIT OPENINGS

THAT ALLOW PASSAGE OF A 4" (102,MM) DIAMETER SPHERE SUCH OPENINGS ARE LOCATED

2. GLAZING ADJACENT TO A DOOR WHERE THE BOTTOM EXPOSED EDGE OF THE GLAZING IS

INCHES OF EITHER SIDE OF THE DOOR OR IS ON A WALL PERPENDICULAR TO THE PLANE

THERE IS AN INTERVENING WALL/ PERMANENT BARRIER BETWEEN THE DOOR &

LESS THAN 60 INCHES ABOVE THE FLOOR OR WALKING SURFACE AND IS WITHIN 24

OF THE DOOR & WITHIN 24 INCHES OF THE HINGE SIDE OF AN IN-SWINGING DOOR.

2.1. EXCEPTIONS: GLAZING IS ADJACENT TO A FIXED PANEL OF PATIO DOORS OR

5. GLAZING ADJACENT TO BATHTUBS, SHOWERS, SWIMMING POOLS, HOT TUBS, ETC.

WHERE THE BOTTOM EXPOSED EDGE OF THE GLAZING IS LESS THAN 60 INCHES

THAN 36 INCHES ABOVE THE PLANE OF THE ADJACENT WALKING SURFACE.

KRAFT FACING ON THE HEATED SIDE AS SHOWN IN THE DOCUMENTS.

VERTICALLY ABOVE ANY STANDING OR WALKING SURFACE AND LESS THAN 60 INCHES

6. GLAZING ADJACENT TO STAIRS AND RAMPS WHERE THE BOTTOM EXPOSED EDGE IS LESS

GLASS AND HAVE A CROSS SECTIONAL HEIGHT OF 1-1/2 INCHES OR MORE.

1. THE CONTRACTOR SHALL PROVIDE AND INSTALL GLASS FIBER INSULATION BATTS WITH

2. INSULATION SHALL BE INSTALLED IN THE FOLLOWING THICKNESS <u>IF RESCHECK IS NOT</u>

GLAZING 34-38 INCHES ABOVE THE WALKING SURFACE. RAIL SHALL WITHSTAND

HORIZONTAL LOAD OF 50 POUNDS PER LINEAR FOOT WITHOUT CONTACTING THE

6.1. EXCEPTIONS: WHERE A RAIL IS INSTALLED ON THE ACCESSIBLE SIDE OF THE

3. BOTTOM OF GLAZING IS LESS THAN 18 INCHES ABOVE THE FLOOR

ALL DIMENSIONS AND CONDITIONS SHOWN AND ASSUMED ON THESE DOCUMENTS MUST BE MATERIAL OR DOING ANY WORK. ANY DISCREPANCIES OR ERRORS IN THE DOCUMENTS MUST BE REPORTED TO THE ARCHITECT AT ONCE. NO CHANGE IN PLANS, DETAILS OR DIMENSIONS IS

PROVIDED: 2.1. IN 2 X 4 EXTERIOR WALLS IN BASEMENT: 3-1/2" (R-13 OR R-15) ON THE INTERIOR OF THE BASEMENT WALL. 2.2. IN 2 X 6 EXTERIOR WALLS: 5-1/2" (R-21).

INSULATION:

- 2.3. IN FLOOR: 9" CAVITY (R-30).
- 2.4. IN FLOOR: 11" CAVITY (R-38 HIGH DENSITY)
- 2.5. IN ROOF AND FLAT CEILING AREAS: 15-1/2" (R-49)
- 2.6. PROVIDE STYROFOAM BAFFLES AT CATHEDRAL, TRAY OR FLAT ROOFED AREAS TO ALLOW ADEQUATE AIR CIRCULATION.
- 3. IN AREAS WHERE THE ABOVE R VALUES CANNOT BE REACHED IN THE SPACE PROVIDED
- WITH FIBERGLASS INSULATION, CLOSED CELL SPRAY FOAM INSULATION SHALL BE USED. 4. INSULATION FOR SOUND SHALL BE INSTALLED IN ALL BATHROOM AND POWDER ROOM WALLS AS WELL AS IN ALL FRAMING BAYS (HORIZONTAL AND VERTICAL) CONTAINING PLUMBING WASTE PIPES OR WATER SUPPLY PIPES.

GYPSUM WALL & CEILING BOARDS:

1. GYPSUM WALL AND CEILING BOARDS SHALL BE 1/2" THICKNESS AS MANUFACTURED BY U.S. GYPSUM, WITH TAPED EDGES FOR PERF-A-TAPE JOINT SYSTEM WITH THE GYPSUM BOARD GLUED AND SCREWED, NOT NAILED.

- 2. THE CONTRACTOR SHALL TAPE. SPACKLE AND SAND ALL JOINTS (SPACKLING AND SANDING THREE TIMES), ON THE NEW GYPSUM BOARD CEILING AND WALLS, TO PROVIDE A SMOOTH, CLEAN SURFACE WHICH ARE READY FOR PAINTING AND FINISHING. EXTERIOR CORNERS SHALL HAVE METAL CORNER BEADS AND EXPOSED EDGES SHALL
- HAVE "J" MOLD. NO EXPOSED UNFINISHED EDGES WILL BE PERMITTED. 3. WATER-RESISTANT GYPSUM BOARD (GREEN BOARD) SHALL BE USED AT ALL WET AREAS.
- 4. CONCRETE COMPOSITION BOARD SHALL BE USED AT ALL TILED WALL AREAS. 5. BLUE BOARD SHALL BE USED IN ALL AREAS TO RECEIVE PLASTER SKIM COAT.

6. TYPE X BOARD TO BE USED IN FIRE RATED AREAS. SEE GARAGE NOTES IF APPLICABLE.

TYPICAL WALL CONSTRUCTION:

- 1. USE 2 X 4 STUDS FOR ALL INTERIOR WALLS U.O.N. ALL POSTS IN A 2 X 4 WALL SHALL BE (2) 2 X 4 U.O.N.
- 2. USE 2 X 6 STUDS FOR ALL EXTERIOR WALLS U.O.N. ALL POSTS IN A 2 X 6 WALL SHALL BE (2) 2 X 6 U.O.N. 3. IF A NEW WALL IS BEING CONSTRUCTED ADJACENT TO AN EXISTING WALL, THE EXISTING
- WALL THICKNESS SHALL BE MATCHED. 4. TYPICAL HEADER: (2) 2 X 10 U.O.N. IN INTERIOR WALLS & (3) 2 X 10 U.O.N IN EXTERIOR

GUARDRAILS:

1. NO MORE THAN 3-15/16" PERMITTED BETWEEN RAILING BALUSTERS OR OTHER CONSTRUCTION. GUARDRAILS TO BE MINIMUM 36" A.F.F.

2. HANDRAILS TO BE MAXIMUM 34" A.F.F.

GARAGE NOTES:

PROVIDE A ONE HOUR FIRE SEPARATION BETWEEN GARAGE AND LIVING AREAS AS FOLLOWS:

- 1. ONE LAYER OF 5/8" TYPE "X" GYPSUM BOARD ON THE INTERIOR WALLS OF THE GARAGE. THE WALL SHALL BE CONTINUOUS TO THE UNDERSIDE OF THE CEILING
- 2. TWO LAYERS OF 5/8" TYPE "X" GYPSUM BOARD ON THE CEILING AND ON DROPPED
- GIRDERS OR BEAMS OF THE GARAGE.
- 3. PROVIDE A 20 MINUTE RATED DOOR BETWEEN THE GARAGE AND HOUSE. REFER TO DOOR SCHEDULE FOR ADDITIONAL INFORMATION.

POST NOTES:

1. ALL PARALLAM, MICROLLAM OR FLITCH BEAMS TO BEAR ON PARALLAM POSTS. POST SIZE TO MATCH WALL DEPTH X BEAM WIDTH MINIMUM.

2. SEE PROJECT SPECIFICATIONS FOR TYPICAL POST SIZES

EXISTING STRUCTURAL NOTES:

THE EXISTING STRUCTURE INDICATED ON THE PLANS IS ASSUMED. THE CONTRACTOR SHALL EXPOSE THE EXISTING STRUCTURE AS REQUIRED TO CONFIRM THE TRUE CONDITIONS BEFORE PROCEEDING WITH THE WORK. NOTIFY & CONSULT WITH THE ARCHITECT IF THE STRUCTURE VARIES FROM THE ASSUMED CONDITIONS. NOTE THAT ADDITIONAL STRUCTURAL WORK MAY BE REQUIRED AFTER THE EXISTING STRUCTURAL MEMBERS ARE EXPOSED FOR EVALUATION. THE CONTRACTOR SHALL BE RESPONSIBLE FOR THE DETERMINATION AND INSTALLATION OF ADEQUATE TEMPORARY SUPPORTS FOR THE EXISTING STRUCTURE BEFORE THE REMOVAL OF ANY BEARING WALLS, BEAMS, AND GIRDERS OR STRUCTURAL POSTS.

FRAMING NOTES:

- 1. FRAMING LUMBER SHALL BE DOUGLAS-FIR-LARCH, CONSTRUCTION GRADE WITH A MODULUS OF ELASTICITY OF 1,500,000 OR BETTER FOR STUDS, AND 1,600,00 OR BETTER FOR JOISTS, RAFTERS, BEAMS, AND GIRDERS. PROVIDE PRESERVATIVES TREATED LUMBER WHERE SPECIFIED OR WHERE IN CONTACT WITH MASONRY.
- 2. ALL FLUSH CONNECTIONS OF MEMBERS SHALL BE GALVANIZED HANGERS, AS REQUIRED BY LOADING CONDITIONS BY 'SIMPSON' OR APPROVE EQUAL. AT EXTERIOR USES OR IN CONTACT WITH PRESSURE TREATED LUMBER, HANGERS SHALL BE HOT DIPPED GALVANIZED. FASTENERS USED AT PRESSURE TREATED LUMBER SHALL ALSO BE Z-MAX
- 3. UNLESS INDICATED, NO FRAMING MATERIAL SUBSTITUTION SHALL BE MADE WITHOUT THE EXPRESS CONSENT OF THE ARCHITECT.
- 4. ALL BEAMS, FLASHING, FASTENERS (NAILS, SCREWS, BOLTS, HANGERS, ETC.) ANCHORS AND HANGERS IN CONTACT WITH PRESERVE TREATED LUMBER SHALL BE COMPATIBLE WITH SUCH AND SHALL RESIST GALVANIC ACTION PER CODE.
- 5. NO SATURATED LUMBER (GREATER THAN 18%) SHALL BE USED DURING TIME OF FRAMING REPAIRS OR INSTALLATION. CONTRACTOR SHALL BE RESPONSIBLE FOR MAINTAINING ALL LUMBER. LUMBER SHALL BE STORED AND ELEVATED OFF THE GROUND AND COVERED FROM AND PROTECTED FROM THE ELEMENTS.
- ALL NEW POSTS AND COLUMNS TO BEAR ON SOLID MASONRY FOUNDATION.
- 7. NEW FINISHED FLOOR ABOVE TO ALIGN WITH EXISTING. SET NEW FLOOR JOISTS TO ACCOMMODATE A FLUSH FINISH FLOOR ABOVE
- 8. PROVIDE 5/4" X 3" DIAGONAL BRIDGING OR MATCHING DEPTH 2X OR 'SIMPSON' TB BRIDGING AT 8'-0" O.C. FOR ALL JOISTS.
- 9. PROVIDE DOUBLE JOISTS UNDER ALL PARALLEL PARTITIONS, TUBS, AND WHIRLPOOLS
- UNLESS OTHERWISE NOTED. IF CAST-IRON TUB IS SELECTED, VERIFY WHETHER REINFORCING IN FLOORS IS REQUIRED. CONSULT WITH ARCHITECT.
- PROVIDE 'SIMPSON' JOIST HANGERS AT ALL FLUSH BEAM CONNECTIONS.
- 11. LEDGERS TO BE SCREWED WITH 2 ROWS OF 5/16" SCREWS 16" O.C. OR THROUGH BOLTED WITH 5/8" DIAMETER A307 BOLTS @ 18" O.C. STAGGERED UP AND DOWN WITH (2) BOLTS IN A VERTICAL ROW AT EACH END WITH (2) BOLTS PER PIECE MINIMUM.
- 11.1. DECK LEDGERS (R507.2.4): 11.1.1. WHERE FLOOR JOISTS ARE PERPENDICULAR TO LEDGER: PROVIDE A MINIMUM OF (2) SIMPSON DTT2Z DECK TENSION TIE PER DECK WITHIN 24" OF EACH END
- 11.1.2. WHERE FLOOR JOISTS ARE PARALLEL TO LEDGER: PROVIDE A MINIMUM OF (4) HOLD DOWN DEVICES (MIN. 750 LB CAPACITY) PER DECK. PROVIDE (1) DEVICE WITHIN 24" OF EACH END OF DECK. SPACE EQUALLY. CONNECT DEVICE TO TOP

PLATE, STUDS OR HEADER W/ 3/8" DIAMETER A307 BOLTS (MIN. 3" EMBEDMENT)

STRUCTURAL NOTES:

STRESS-GRADE LUMBER SHALL BE DOUGLAS FIR (NO. 1/NO. 2) OR APPROVED EQUAL WITH MINIMUM ALLOWABLE STRESS AS FOLLOWS:

FB = 850 PSI STRESS IN EXTREME FIBER IN BENDING FV = 95 PSIHORIZONTAL SHEAR COMPRESSION PERPENDICULAR TO GRAIN FC = 625 PSI **COMPRESSION PARALLEL TO GRAIN** FC = 1,400 PSI MODULUS OF ELASTICITY E = 1,600,000 PSI

PARALLAM (PSL) BEAMS AND HEADER SHALL BE MADE FROM LONG, THIN STRANDS OF WOOD STRUCTURALLY BONDED TOGETHER IN PATENTED MICROWAVE PROCESS BY TRUSS JOIST CORPORATION OR APPROVED EQUAL. PARALLAM SHOULD HAVE A MINIMUM ALLOWABLE UNIT STRESSES AS FOLLOWS:

STRESS IN EXTREME FIBER IN BENDING FB = 2,900 PSI TENSION PARALLEL TO GRAIN FT = 1,800 PSI COMPRESSION PERPENDICULAR TO GRAIN FC = 650 PSI COMPRESSION PARALLEL TO GRAIN FC = 2,900 PSI HORIZONTAL SHEAR FV = 290 PSI MODULUS OF ELASTICITY E = 2,000,000 PSI

MICROLLAM NOTES

MICROLLAM LAMINATED (ML) VENEER LUMBER SHALL BE MANUFACTURED FROM THIN SHEETS OF VENEER STRUCTURALLY BONDED TOGETHER BY TRUSS JOIST CORPORATION OR EQUAL TO MAKE BEAMS AND HEADERS. THEY SHALL HAVE ALLOWABLE UNIT STRESSES AS FOLLOWS:

STRESS IN EXTREME FIBER IN BENDING FB = 2,600 PSITENSION PARALLEL TO GRAIN FT = 1,800 PSI COMPRESSION PERPENDICULAR TO GRAIN FC = 750 PSI **COMPRESSION PARALLEL TO GRAIN** FC = 2,310 PSI HORIZONTAL SHEAR FV = 285 PSI MODULUS OF ELASTICITY E = 2,000,000 PSI


FINISH NOTES:

GC. TO PROVIDE & INSTALL THE BELOW U.O.N

- 1. ALL WALLS & CEILING TO BE FINISHED WITH GYPSUM BOARD U.O.N. SEE PROJECT SPECIFICATIONS FOR SIZE AND TYPE.
- 2. FLOORING (OWNER TO SELECT WOOD SPECIES & COLOR, TILE TYPE & COLOR): 2.1. HARDWOOD: IN NEW PLAY ROOM, FAMILY ROOM, EXISTING OFFICE, KITCHEN &
- NEW DINING ROOM, BEDROOMS & HALL U.O.N. 2.2. TILE: IN ALL BATHROOMS U.O.N. & GARAGE PLATFORM.
- 3. SEE KITCHEN NOTES FOR KITCHEN FINISHES.
- 4. ALL BEDROOM CLOSETS TO HAVE A ROD & SHELF INSTALLED.
- 5. PANTRY AND LINEN CLOSETS TO HAVE 5 ADJUSTABLE 1" THICK CABINET PLYWOOD SHELVES (WITH FINISHED EDGES). COORDINATE WITH OWNER FOR DEPTH.
- 6. ENTRY HALL CLOSETS TO HAVE ROD & SHELF INSTALLED.
- 7. ALL PLUMBING FIXTURES TO BE PROVIDED BY OWNER & INSTALLED BY G.C. 8. T.O. DENOTES TRIMMED OPENING.
- 9. FRAMELESS GLASS SHOWER ENCLOSURES IN ALL BATHROOMS
- 10. TRIM (OWNER TO SELECT PROFILES):
- 10.1. CROWN: 6" PAINT GRADE CROWN THROUGHOUT FIRST FLOOR 10.2. CASING: 4" PAINT GRADE CASING
- 10.3. BASE: 4" PAINT GRADE IN ALL ROOMS WITH HARDWOOD FLOOR. 4" TILE IN ALL

BATHROOMS & GARAGE

COPYRIGHT 2021. theodora boyadjis designs, Ilc. ALL RIGHTS RESERVED. ALL DESIGNS AND CONCEPTS SHOWN ON DRAWINGS ARE PROPERTY LOCATION, COPIED, SOLD OR SHARED WITH ANY PERSONS, FIRMS OR CORPORATIONS WITHOUT EXPRESSED WRITTEN PERMISSION. PROJ. NO.: John21001

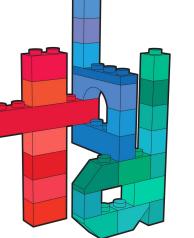

908.208.6085 299 barrow street #32 jersey city, nj 07302 theodorabdesigns.com 🛨

theodora boyadjis, RA, LEED AP

NJ: 21AI01985000 NY: 039265

CONSULTANTS:

CLIENT MEETING 05.27.2021 **CLIENT MEETING** 06.14.2021 **ISSUE FOR BID** 06.29.2021 09.10.2021 **CLIENT MEETING** CLIENT REVIEW 10.08.2021 PERMIT SET 10.21.2021 **ISSUE FOR PERMIT** 11.08.2021 ISSUE FOR PERMIT 01.28.2021 ISSUE FOR PERMIT 02.16.2022 07.26.2022 REVISION


REVISION


JOHNSON/ZIMMERMAN **RESIDENCE** 54 MYRTLE AVENUE METUCHEN NJ

SECOND FLOOR CONSTRUCTION PLAN,

NOTES

DATE: 05.10.2021 DRAWN BY: SP SCALE: AS NOTED | CHECKED BY: TB

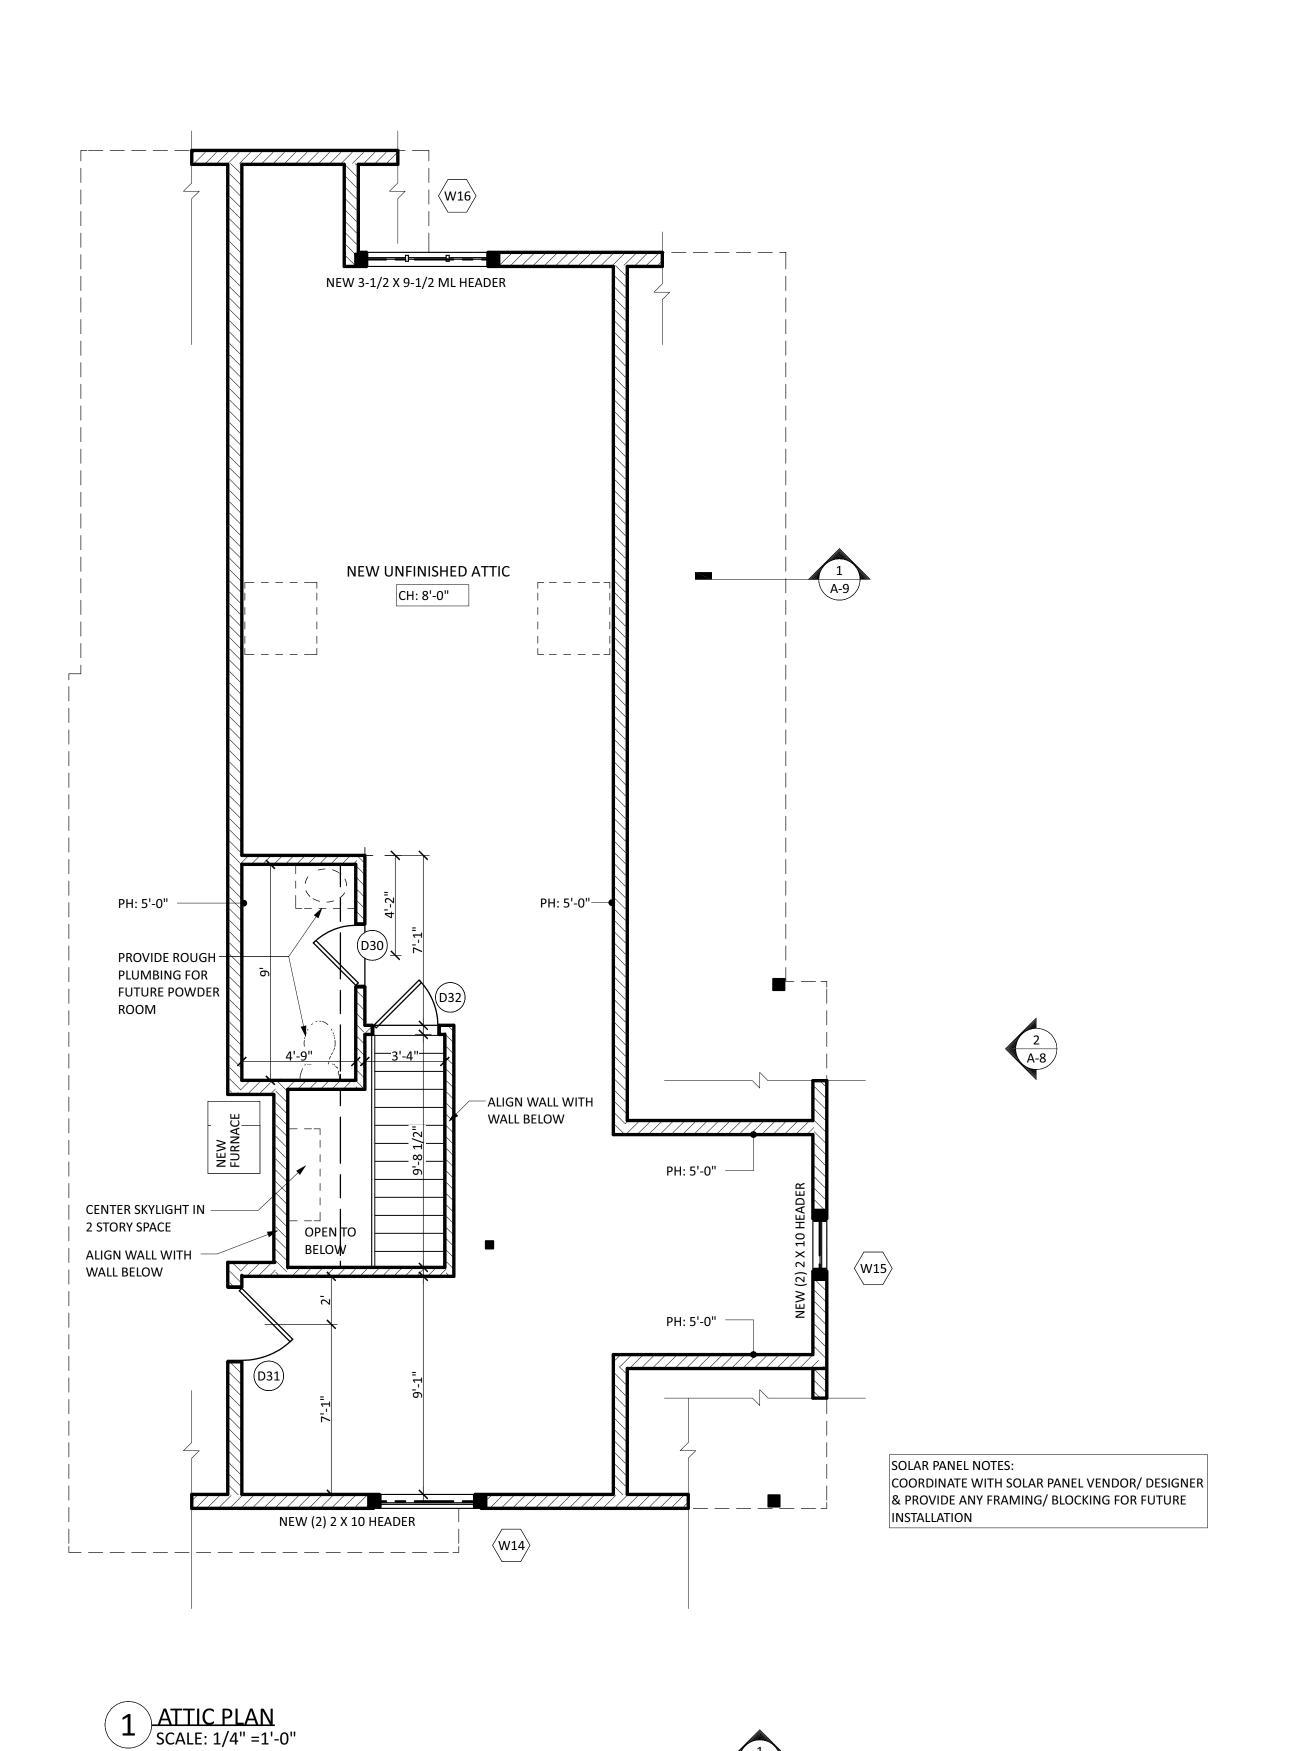

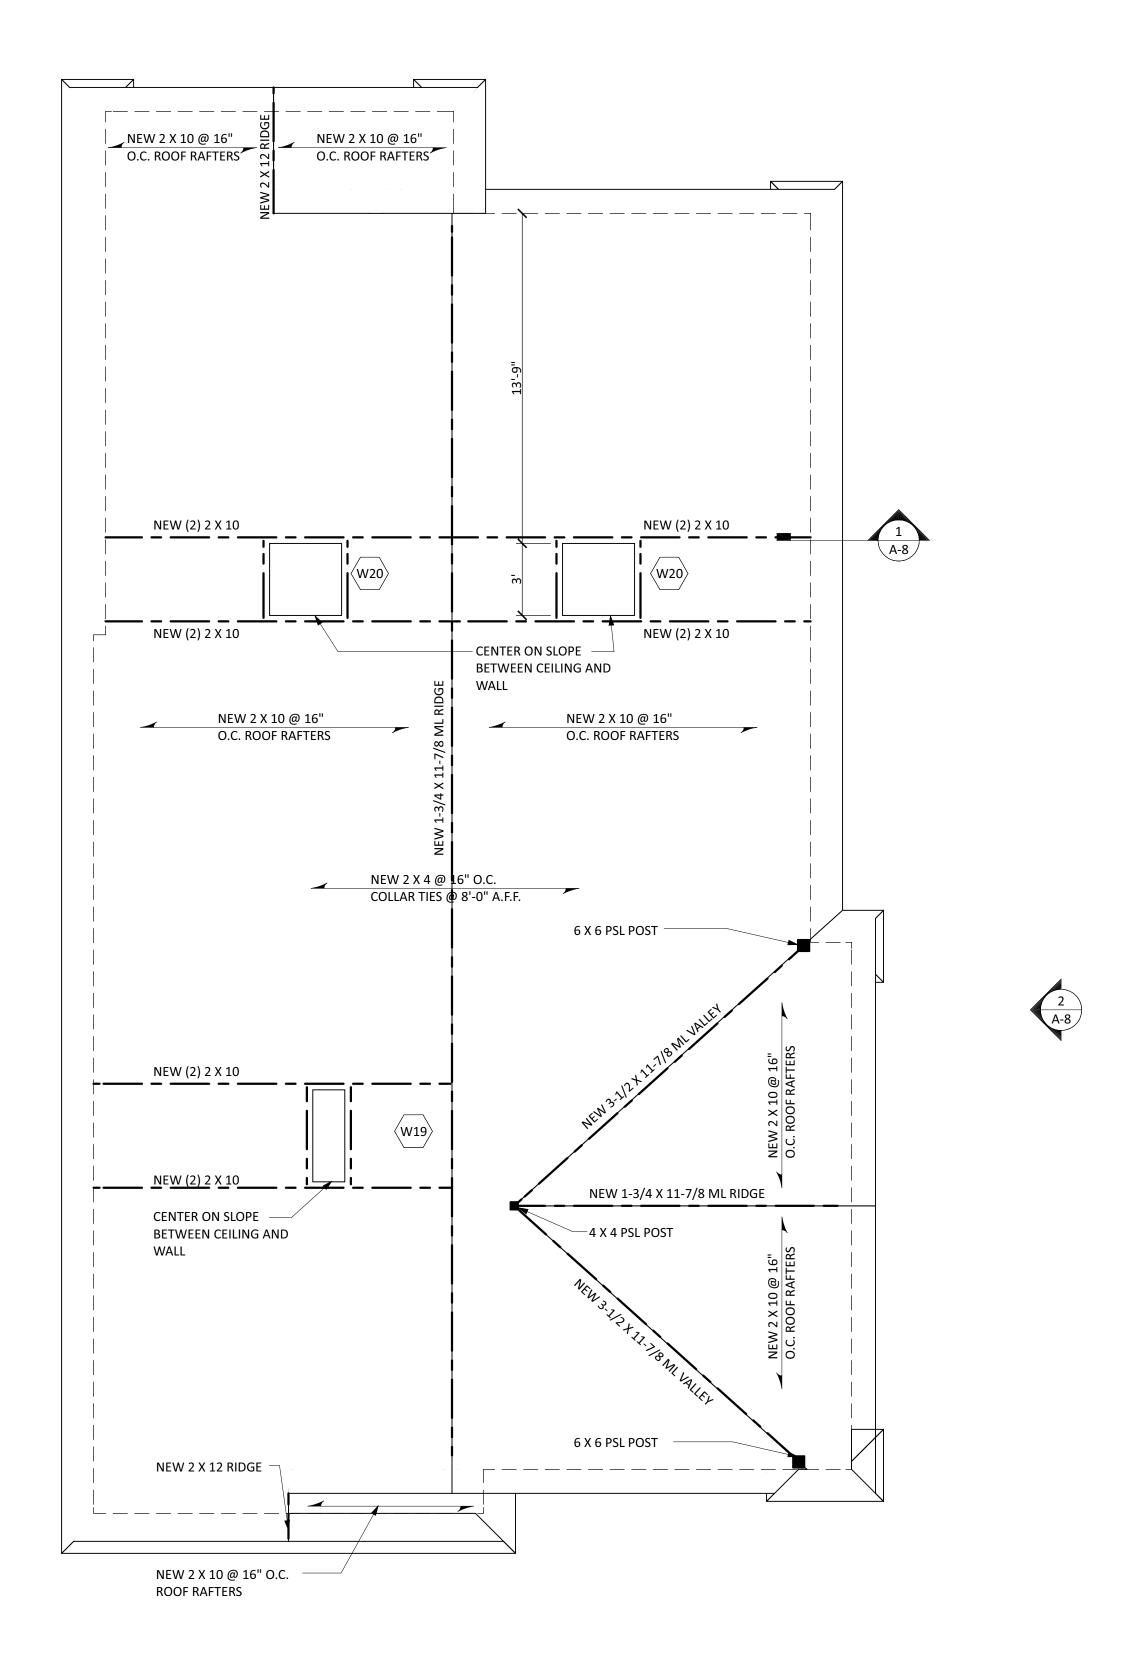

2 ROOF PLAN SCALE: 1/4" =1'-0"

908.208.6085
299 barrow street #32
jersey city, nj 07302
theodorabdesigns.com

theodora boyadjis, RA, LEED AP NJ: 21AI01985000 NY: 039265

CONSULTANTS:

1 CLIENT MEETING 05.27.2021
2 CLIENT MEETING 06.14.2021
3 ISSUE FOR BID 06.29.2021
4 CLIENT MEETING 09.10.2021
5 CLIENT REVIEW 10.08.2021
6 PERMIT SET 10.21.2021
7 ISSUE FOR PERMIT 11.08.2021
8 ISSUE FOR PERMIT 01.28.2021
1 REVISION 07.26.2022

NO. REVISION


JOHNSON/ZIMMERMAN RESIDENCE 54 MYRTLE AVENUE METUCHEN NJ

ATTIC & ROOF PLAN

DATE: 05.10.2021 DRAWN BY: SP
SCALE: AS NOTED CHECKED BY: TB

A-5

COPYRIGHT 2021. theodora boyadjis designs, Ilc. ALL RIGHTS RESERVED. ALL DESIGNS AND CONCEPTS SHOWN ON DRAWINGS ARE PROPERTY LOCATION, COPIED, SOLD OR SHARED WITH ANY PERSONS, FIRMS OR CORPORATIONS WITHOUT EXPRESSED WRITTEN PERMISSION. PROJ. NO.: John21001 5 SHEET OF 12

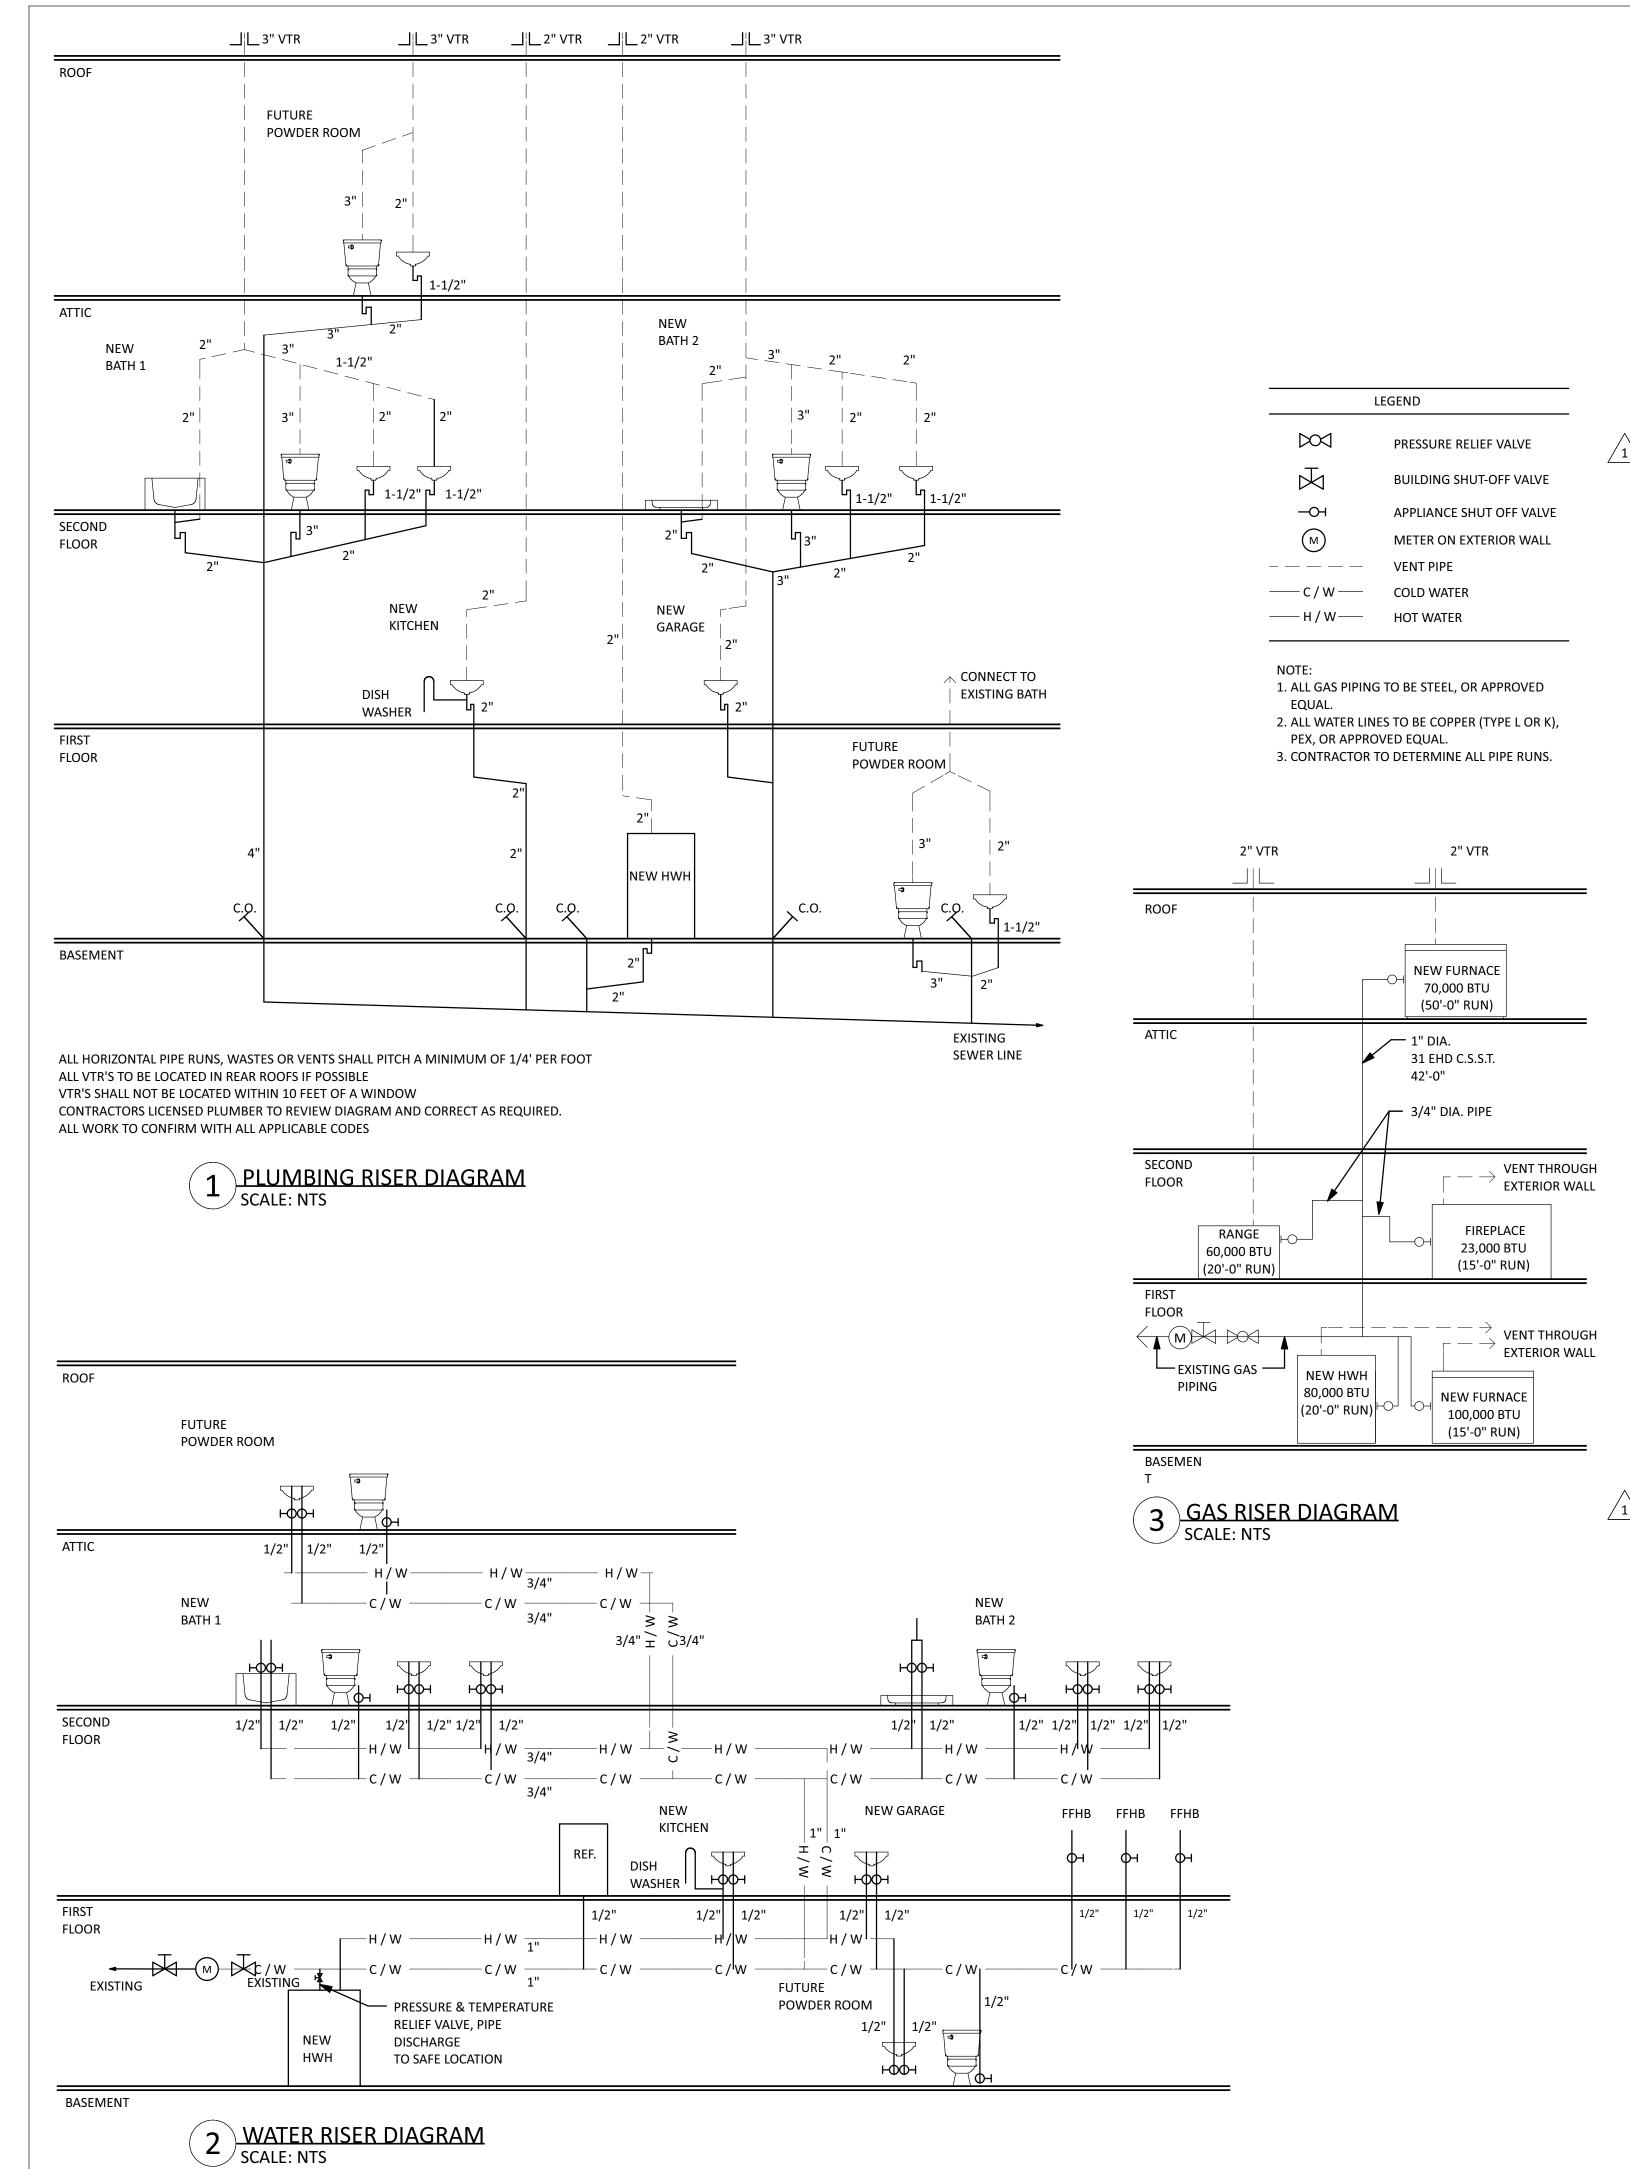

						WIND	OOW SCHEDULE
SYM.	WIDTH	HEIGHT	DESCRIPTION	QTY	EGRESS	TEMPERED	MANUFACTURER COMMENTS
W01	36 "	41 1/2 "	CASEMENT	2			ANDERSEN 100 SERIES
W02	38 "	57 "	DOUBLE HUNG	1			ANDERSEN 200 SERIES
W03	60 "	20 "	FIXED	2			ANDERSEN 400 SERIES
W04	63 "	36 "	DOUBLE CASEMENT	1			ANDERSEN 400 SERIES CONFIRM SILL IS MIN. 3'-6" A.F.F. PRIOR TO ORDERING
W05	112 "	56 "	DOUBLE-HUNG	1			ANDERSEN 200 SERIES 2" MULL, TRIPLE
W06	36 "		EXISTING	1			EXISTING RELOCATE FROM EXSITING BEDROOM
W07	65 "	48 "	DOUBLE HUNG	1			ANDERSEN 200 SERIES 2" MULL; PAIR
W08		48 "	DOUBLE HUNG	1		YES	ANDERSEN 200 SERIES 2" MULL; PAIR
W09	36 "		DOUBLE HUNG	4	YES		ANDERSEN 200 SERIES
W10	24 "	42 "	DOUBLE HUNG	1			ANDERSEN 200 SERIES
W11	24 "	42 "	DOUBLE HUNG	2		YES	ANDERSEN 200 SERIES
W12		48 "	CASEMENT	1			ANDERSEN 400 SERIES
W13	74 "		DOUBLE HUNG	1	YES		ANDERSEN 200 SERIES 2" MULL; PAIR
W14	48 "	24 "	AWNING	1			ANDERSEN 400 SERIES
W15	26 1/2 "	40 1/2 "V.I.F.	EXISTING	1			EXSTING RELOCATE FROM EXISTING FIRST FLOOR BATHROOM
W16	61 "	36 "	TRIPLE CASEMENT	1			ANDERSEN 400 SERIES
W17	74 "	56 1/2 "	DOUBLE HUNG	1	YES		ANDERSEN 200 SERIES 2" MULL, PAIR
W18	24 "	36 "	SKYLIGHT	2			VELUX FIXED WITHOUT CURB
W19		48 "	SKYLIGHT	1			VELUX FIXED WITHOUT CURB
W20	36 "	36 "	SKYLIGHT	2			VELUX FIXED WITHOUT CURB

- 1. ALL UNITS SHALL BE 'ANDERSEN' OR APPROVED EQUAL WITH WOOD PRIMED FRAMES, AND INSULATED, LOW E, ARGON FILLED GLASS, WITH SCREENS ON OPERABLE UNITS, VERIFY JAMB SIZES IN FIELD.
- 2. CASING AND SILLS TO BE SELECTED, CONFIRM SCREEN AND HARDWARE COLOR AND FINISH SELECTIONS WITH OWNER PRIOR TO ORDERING
- 3. SEE PLANS AND ELEVATIONS FOR HEAD HEIGHTS, LITE PATTERNS, HINGING, AND WINDOW HEADER SIZES
- 4. WINDOWS AT TUB AND STAIRS TO BE TEMPERED. SEE PROJECT SPECIFICATIONS FOR OTHER LOCATIONS

	I=: 0 0 0	J	Ta	DOOR SCHEDULE	I		T
SYM.	<u> FLOOR</u>	LOCATION EVICTOR	DIMENSIONS	DESCRIPTION	MANUF.	TEMPERED	INOTES
001	0	EXISTING UNFINISHED BASEMENT/NEW UNFINISHED BASEMENT	30"X80"X1 3/4" R IN	6 PANEL TO MATCH EXISTING	SIMPSON OR EQUAL		
002	0	NEW UNFINISHED BASEMENT/BASEMENT ENTRY	36"X80"X1 3/4" L IN V.I.F.	EXISTING	EXISTING		RELOCATE FROM FIRST FLOOR ENTRY
003	0	UNDER DECK STORAGE	36"X48"X1 3/4" L EX V.I.F.	EXTERIOR			UNDER DECK ACCESS
004	1	NEW FOYER/NEW COVERED PORCH	42"X80"X1 3/4" R EX	EXTERIOR	ANDERSEN		OWNER TO SELECT
D05	1	NEW MUDROOM/NEW FOYER	32"X80"X1 3/8" R	FLAT 1 PANEL POCKET	SIMPSON OR EQUAL		PROVIDE "JOHNSON" 1500SC HARDWARE
006	1	MODIFIED KITCHEN/ BASEMENT	30"X80"X1/16" R IN V.I.F.	EXISTING	EXISTING		PAINT EXISTING DOOR
007	1	NEW FOYER/NEW GARAGE	36"X80"X1 3/4" R EX	6 PANEL TO MATCH EXISTING	SIMPSON OR EQUAL		20 MIN. FIRE RATED
800	1	EXISTING BATH/ MODIFIED KITCHEN	30"X80"X1/16" R IN V.I.F.	EXISTING	EXISTING		PAINT EXISTING DOOR
009	1	MODIFIED KITCHEN/ EXISTING OFFICE	32"X80"X1 3/4" L IN	6 PANEL TO MATCH EXISTING	SIMPSON OR EQUAL		
010	1	EXISTING OFFICE/NEW FAMILY ROOM	(2) 30"X80"X1 3/4" L/R IN	INTERIOR FRENCH	SIMPSON OR EQUAL		PAIR
011	1	NEW GARAGE	120"X96"X1 3/4"	OVERHEAD	CLOPAY OR EQUAL		OWNER TO SELECT
012 013	1	NEW GARAGE NEW PLAY ROOM/NEW DECK	(3) 36"X80"X1 3/4" L EX	EXTERIOR SLIDER	ANDERSEN ANDERSEN		OWNER TO APPROVE PRIOR TO ORDERING TRIPLE, OWNER TO APPROVE PRIOR TO ORDERING. CENTER PANEL TO BE OPERABLE
)14	2	NEW BEDROOM/HALL	32"X80"X1 3/4" L IN	FLAT 1 PANEL	SIMPSON OR EQUAL		
)15	2	NEW CL./HALL	(2) 18"X80"X1 3/4" L/R IN	FLAT 1 PANEL	SIMPSON OR EQUAL		PAIR
)16	2	NEW MASTER BEDROOM/HALL	32"X80"X1 3/4" L IN	FLAT 1 PANEL	SIMPSON OR EQUAL		
)17		HALL/NEW LINEN	(2) 24"X80"X1 3/4" L/R IN		SIMPSON OR EQUAL		PAIR
)18	2	NEW CL./NEW BEDROOM	30"X80"X1 3/4" L IN	FLAT 1 PANEL	SIMPSON OR EQUAL		PAIR
)19	2	NEW BATH 2/NEW MASTER BEDROOM	30"X80"X1 3/4" R IN	FLAT 1 PANEL	SIMPSON OR EQUAL		
20	2	•	(2) 24"X80"X1 3/4" L/R IN	FLAT 1 PANEL	SIMPSON OR EQUAL		PAIR
)21)22	2	NEW CL./NEW BEDROOM NEW MASTER BEDROOM/NEW W.L.C.	(2) 24"X80"X1 3/4" L/R IN 30"X80"X1 3/4" R IN	FLAT 1 PANEL	SIMPSON OR EQUAL SIMPSON OR EQUAL		PAIR
023	3	IOMIT	~~~~~	~~~~~	~~~~	~~~	~~~~~
)24	2	HALL/NEW BATH 1	30"X80"X1 3/4" R IN	FLAT 1 PANEL	SIMPSON OR EQUAL		
)25	2	NEW BATH 1/NEW BATH	24"X80"X1 3/8" L IN	FLAT 1 PANEL	SIMPSON OR EQUAL		
026	2	HALL/NEW BEDROOM	32"X80"X1 3/4" L IN	FLAT 1 PANEL	SIMPSON OR EQUAL		
27	2	HALL/NEW OFFICE	32"X80"X1 3/4" L IN	FLAT 1 PANEL	SIMPSON OR EQUAL		
)28	2	NEW CL./NEW OFFICE	(2) 30"X80"X1 3/4" L/R IN	FLAT 1 PANEL	SIMPSON OR EQUAL		PAIR
29	2	•	(2) 30"X80"X1 3/4" L/R IN	FLAT 1 PANEL	SIMPSON OR EQUAL		PAIR
30	3	NEW UNFINISHED ATTIC/ NEW POWDER ROOM	30"X80"X1 3/4" V.I.F.	FLAT 1 PANEL	SIMPSON OR EQUAL		
)31	3	NEW UNFINISHED ATTIC/ NEW ATTIC	36"X54"X1 3/4" L IN	FLAT 1 PANEL	SIMPSON OR EQUAL		ATTIC ACCESS
	3	OPEN BELOW/NEW UNFINISHED ATTIC	32"X81"X1 3/4" L EX	FLAT 1 PANEL			
)33	12	HALL/NEW BEDROOM	32"X80"X1 3/4" L IN	FLAT 1 PANEL	SIMPSON OR EQUAL		

- 1. ALL DOORS & HARDWARE TO BE PROVIDED & INSTALLED BY GENERAL CONTRACTOR
- JAMBS TO BE 4" WITH EXTENSIONS TO CREATE LEDGE ON INSIDE OF WINDOW
- 2. ALL DOOR STYLES TO BE APPROVED BY OWNER (PANELS STILES & RAILS TYP.) & HAVE 1-3/4" THICKNESS, PAINT GRADE DOORS TO BE FIR OR PINE
- 3. ALL DOOR HARDWARE TO BE APPROVED BY OWNER.
- 4. ALL EXTERIOR DOORS SHALL BE 'ANDERSEN SERIES' OR APPROVED EQUAL & HAVE A PRIMED EXTERIOR, AND INSULATED, LOW-E, ARGON FILLED GLASS.
- 5. PROVIDE SCREEN DOORS ON ALL EXTERIOR DOORS UNLESS OTHERWISE NOTED BY OWNER.
- 6. SEE PLANS AND ELEVATIONS FOR HEAD HEIGHTS, LITE PATTERNS, HINGING, AND HEADER SIZES

908.208.6085 299 barrow street #32 jersey city, nj 07302 theodorabdesigns.com 🛨

theodora boyadjis, RA, LEED AP NJ: 21AI01985000 NY: 039265

CONSULTANTS:

1	CLIENT MEETING	05.27.2021
2	CLIENT MEETING	06.14.2021
3	ISSUE FOR BID	06.29.2021
4	CLIENT MEETING	09.10.2021
5	CLIENT REVIEW	10.08.2021
6	PERMIT SET	10.21.2021
7	ISSUE FOR PERMIT	11.08.2021
8	ISSUE FOR PERMIT	01.28.2021
9	ISSUE FOR PERMIT	02.16.2022
<u>/1\</u>	REVISION	07.26.2022


REVISION JOHNSON/ZIMMERMAN

RESIDENCE 54 MYRTLE AVENUE METUCHEN NJ

PLUMBING RISER, WATER RISER & GAS RISER DIAGRAMS, DOOR & WINDOW SCHEDULES

DATE: 05.10.2021 DRAWN BY: SP SCALE: AS NOTED CHECKED BY: TB

COPYRIGHT 2021. theodora boyadjis designs, Ilc. ALL RIGHTS RESERVED. ALL DESIGNS AND CONCEPTS SHOWN ON DRAWINGS ARE PROPERTY LOCATION, COPIED, SOLD OR SHARED WITH ANY PERSONS, FIRMS OR CORPORATIONS WITHOUT EXPRESSED WRITTEN PERMISSION. PROJ. NO.: John21001

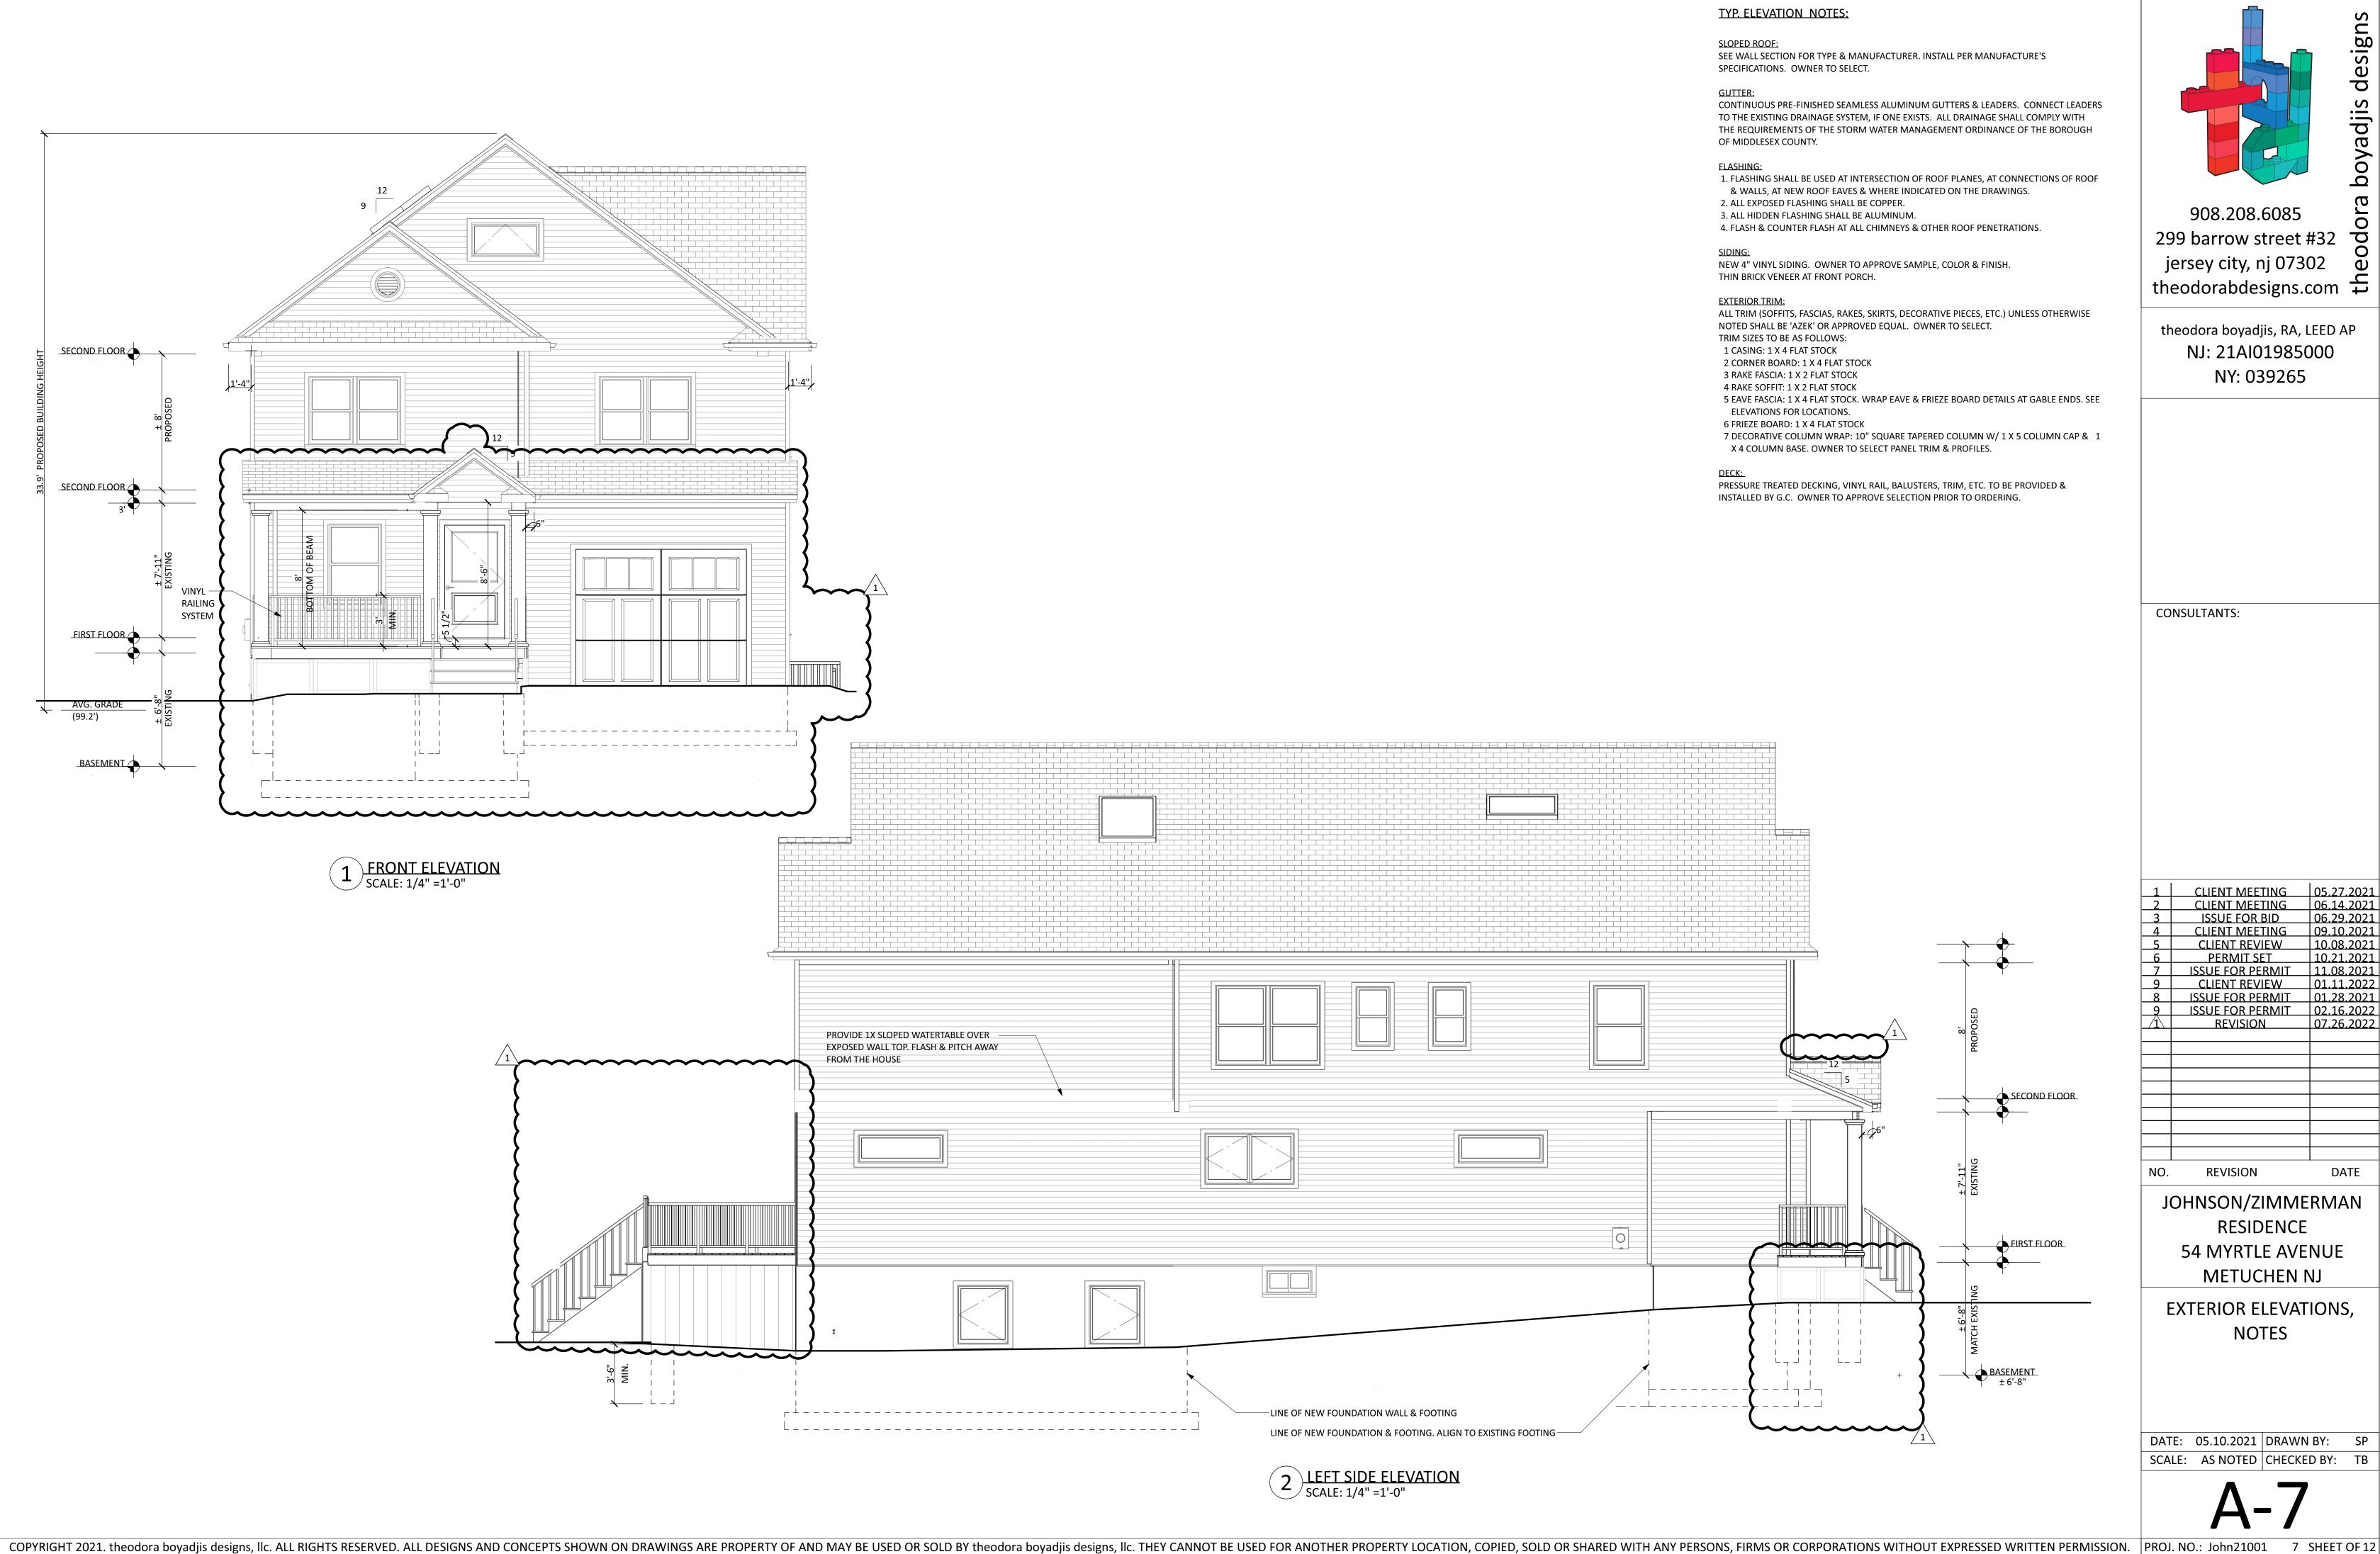

908.208.6085 299 barrow street #32 jersey city, nj 07302 theodorabdesigns.com


theodora boyadjis, RA, LEED AP NJ: 21Al01985000 NY: 039265

05.27.2021 09.10.2021 10.08.2021 10.21.2021 11.08.2021 ISSUE FOR PERMIT CLIENT REVIEW
ISSUE FOR PERMIT **ISSUE FOR PERMIT** 02.16.2022

RESIDENCE 54 MYRTLE AVENUE METUCHEN NJ


EXTERIOR ELEVATIONS,

DATE: 05.10.2021 DRAWN BY: SP SCALE: AS NOTED CHECKED BY: TB

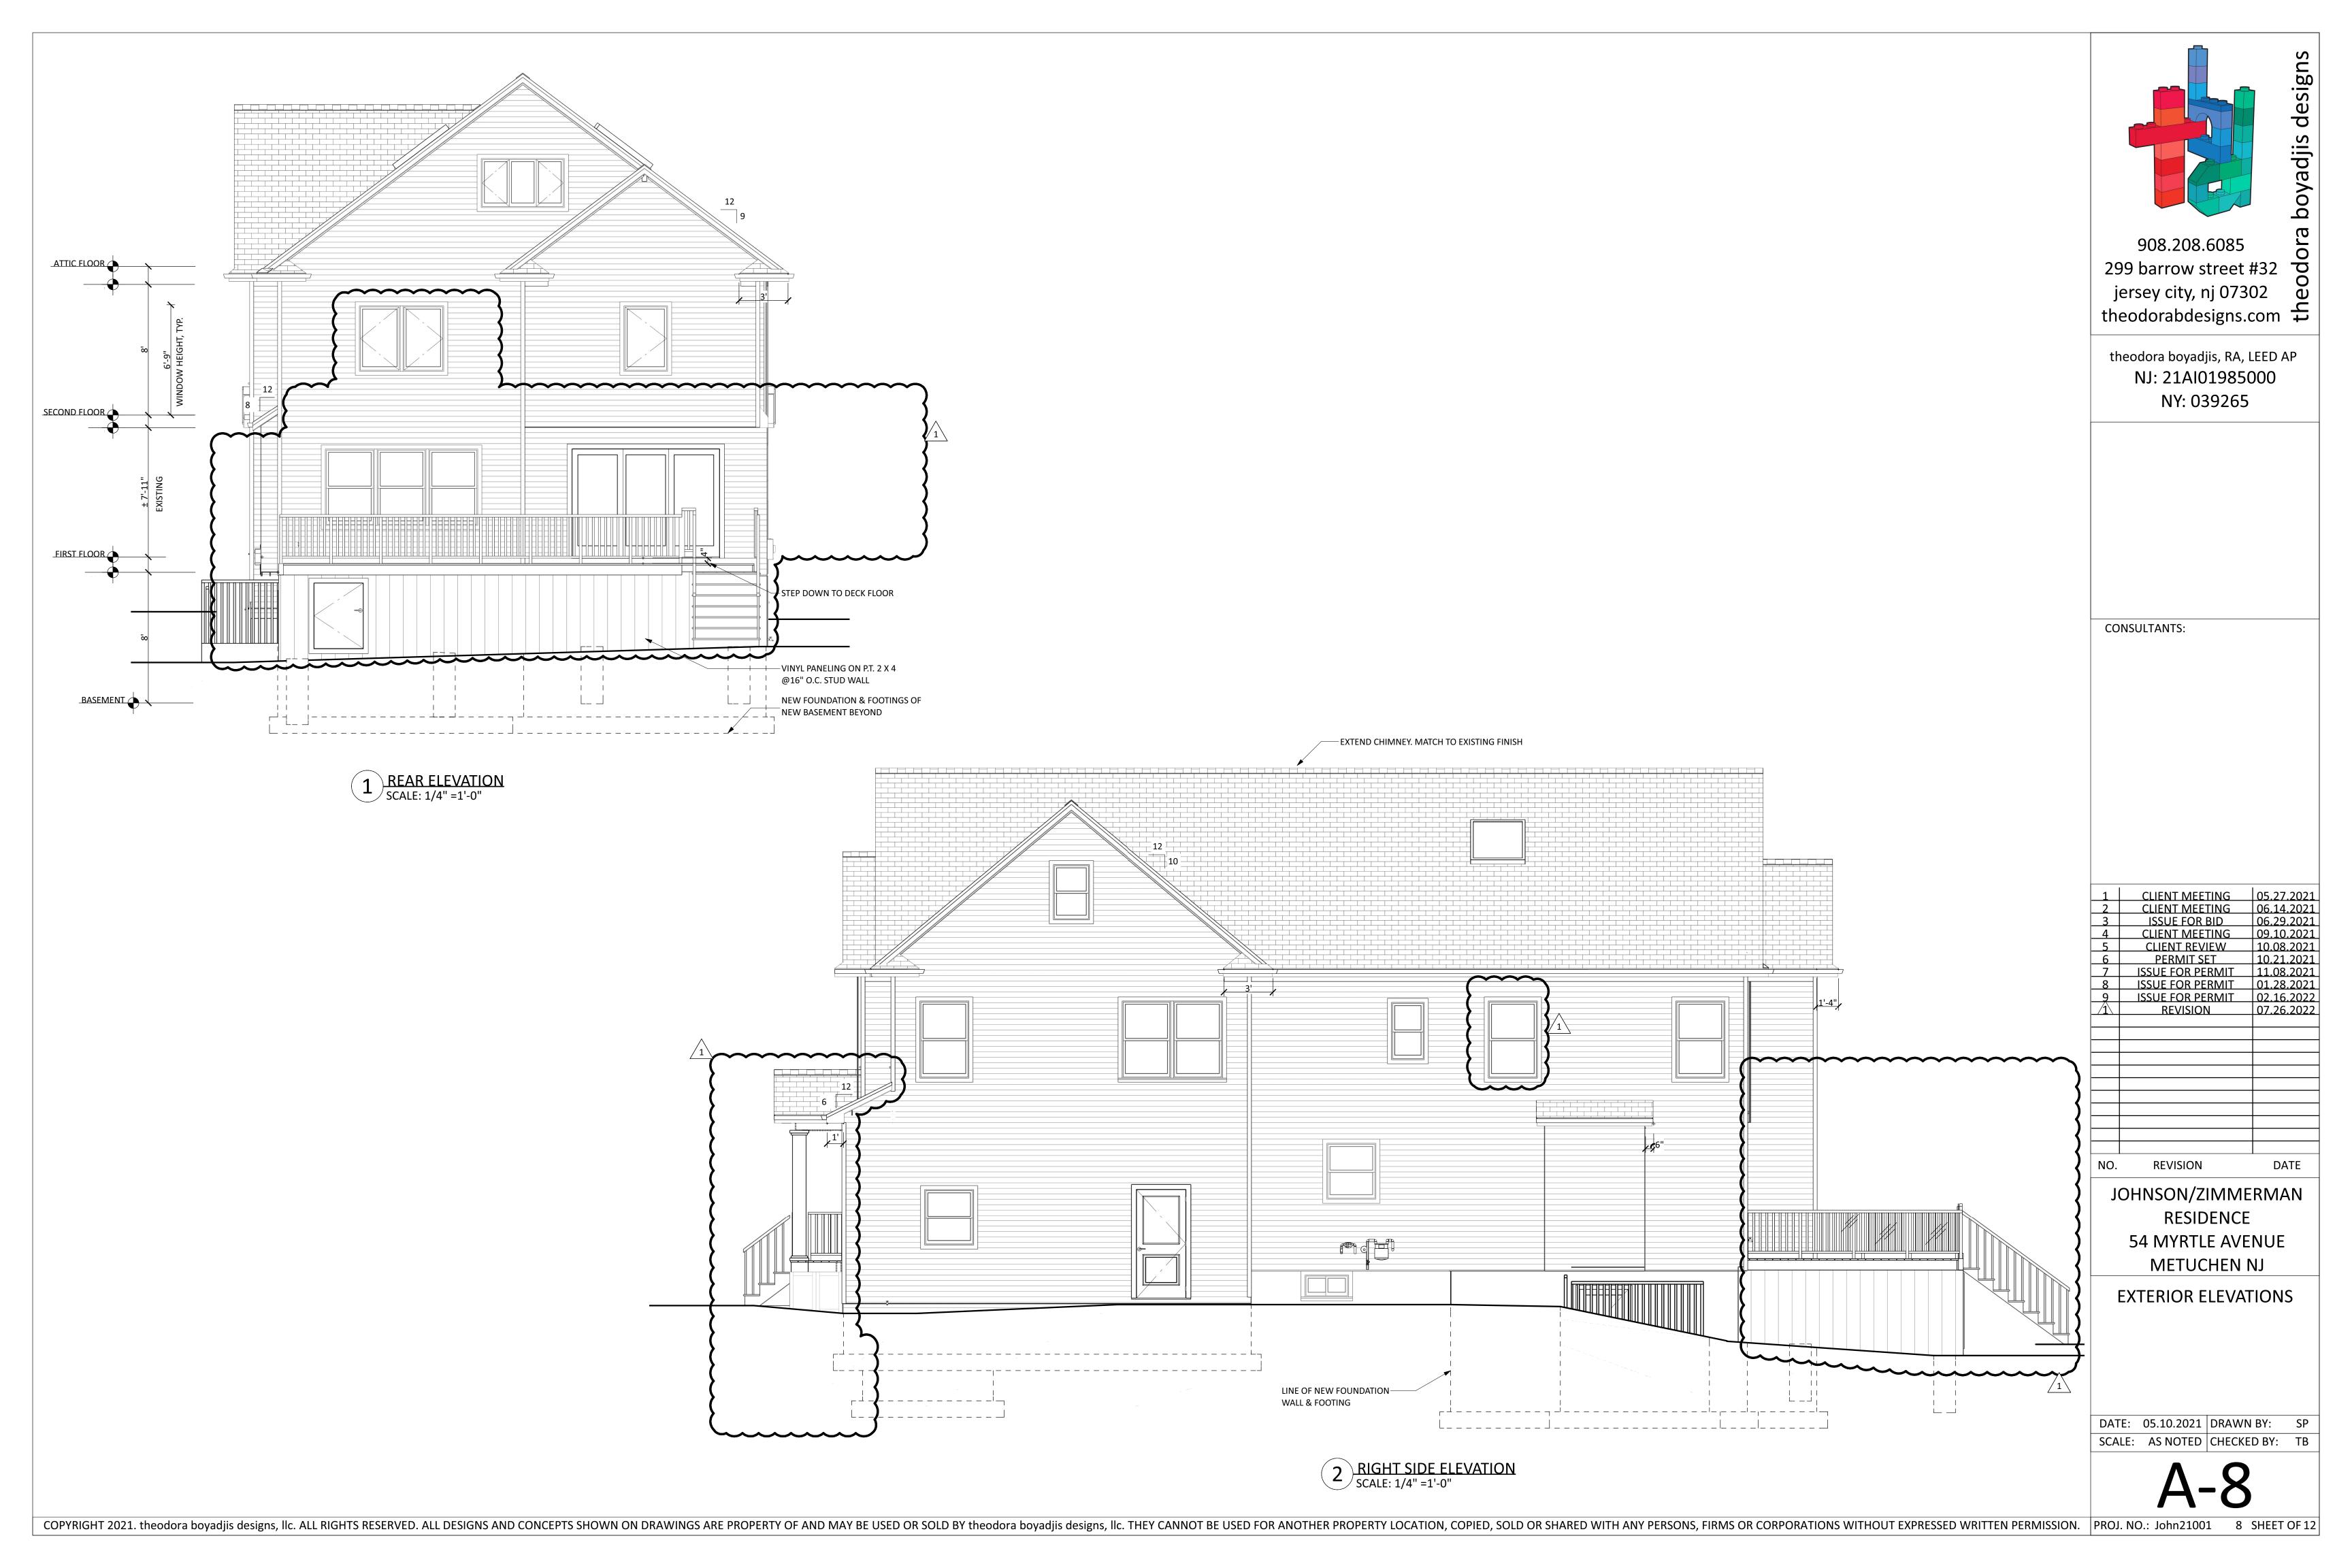



ITEM	DESCRIPTION OF BUILDING ELEMENTS	602.3(1) FASTENING SC NUMBER & TYPE OF FASTENER a,b,c	SPACING & LOCATION
1	BLOCKING BETWEEN CEILING JOISTS OR RAFTERS TO TOP PLATE	ROOF 4 - 8d BOX (2-1/2" X 0.113") OR 3 - 8d COMMON (2-1/2" X 0.131") OR 3 - 10d BOX (3" X 0.128") OR 3 - 3" X 0.131" NAILS	TOENAIL
2	CEILING JOISTS TO TOP PLATE	4 - 8d BOX (2-1/2" X 0.113") OR 3 - 8d COMMON (2-1/2" x 0.131") OR 3 - 10d BOX (3" X 0.128") OR 3 - 3" X 0.131" NAILS	PER JOIST, TOENAIL
3	CEILING JOIST NOT ATTACHED TO PARALLEL RAFTER, LAPS OVER PARTITIONS [SEE SECTION R802.5.2 AND TABLE R802.5.2]	4 - 10d BOX (3" X 0.128") OR 3 - 16d COMMON (3-1/2" X 0.162") OR 4 - 3" X 0.131" NAILS	FACE NAIL
4	CEILING JOIST ATTACHED TO PARALLEL RAFTER (HEEL JOINT) [SEE SECTION R802.5.2, AND TABLE R802.52]	TABLE R802.52	FACE NAIL
5	COLLAR TIE TO RAFTER, FACE NAIL OR 1-1/4" X 20 GA.	4 - 10d BOX (3" X 0.128") OR 3 - 10d COMMON (3" X 0.148") OR	FACE NAIL EACH RAFTER
6	RIDGE STRAP TO RAFTER RAFTER OR ROOF TRUSS TO PLATE	4 - 3" X 0.131" NAILS 3 - 16d BOX (3-1/2" x 0.135") OR 3 - 10d COMMON (3" X 0.148") OR 4 - 10d BOX (3" X 0.128") OR	2 TOE NAILS ON ONE SIDE AND 1 TOE NAIL ON OPPOSITE SIDE OF EACH RAFTER OR TRUSS ¹
		4 - 3" X 0.131" NAILS 4 - 16d BOX (3-1/2" X 0.135") OR 3 - 10d COMMON (3" X 0.148") OR 4 - 10d BOX (3" X 0.128") OR	TOENAIL
7	ROOF RAFTERS TO RIDGE, VALLEY OR HIP RAFTERS OR ROOF RAFTER TO MINIMUM 2" RIDGE BEAM	3 - 16d BOX (3-1/2" X 0.135") OR 2 - 16d COMMON (3-1/2" X 0.162") OR 3 - 10d BOX (3" X 0.128") OR	END NAIL
		3 - 3" X 0.131" NAILS WALL	
8	STUD TO STUD (NOT A BRACED WALL PANELS)	16d COMMON (3-1/2" X 0.162") 10d BOX (3" X 0.128") OR	24" O.C. FACE NAIL
		10d BOX (3 X 0.128) OR 3" X 0.131" NAILS 16d BOX (3-1/2" X 0.135") OR	16" O.C. FACE NAIL
9	STUD TO STUD AND ABUTTING STUDS AT INTERSECTING WALL CORNERS (AT BRACED WALL PANELS)	3" X 0.131" NAIL	12" O.C. FACE NAIL
10	DINIT UD UEADED 70% TO 3% UEADED WITH 4 75% SECOND	16d COMMON (3-1/2" x 0.162") 16d COMMON (3-1/2" x 0.162")	16" O.C. FACE NAIL 16" O.C. EACH EDGE FACE NAIL
10	BUILT-UP HEADER (2" TO 2" HEADER WITH 1/2" SPACER)	16d BOX (3-1/2" x 0.135")	12" O.C. EACH EDGE FACE NAIL
11	CONTINUOUS HEADER TO STUD	5 - 8d BOX (2-1/2" x 0.113") OR 4 - 8d COMMON (2-1/2" X 0.131) OR 4 - 10d BOX (3" X 0.128")	TOENAIL
12	TOP PLATE TO TOP PLATE	16d COMMON (3-1/2" x 0.162") 10d BOX (3" x 0.128") OR	16" O.C. FACE NAIL 12" O.C. FACE NAIL
13	DOUBLE TOP PLATE SPLICE	3" X 0.131" NAILS 8 - 16d COMMON (3-1/2" x 0.162") OR 12 - 16d BOX (3-1/2" X 0.135") OR 12 - 10d BOX (3" X 0.128") OR	FACE NAIL ON EACH SIDE OF END JOINT (MINIMUM 24" LAP SPLICE LENGTH EACH SIDE OF END JOINT)
	BOTTOM PLATE TO JOIST, RIM JOIST, BAND JOIST OR	12 - 3" X 0.131" NAILS 16d COMMON (3-1/2" X 0.162")	16" O.C. FACE NAIL
14	BLOCKING (NOT AT BRACED WALL PANELS)	16d BOX (3-1/2" X 0.135") OR 3" X 0.131" NAILS	12" O.C. FACE NAIL
15	BOTTOM PLATE TO JOIST, RIM JOIST, BAND JOIST OR BLOCKING (AT BRACED WALL PANEL)	3 - 16d BOX (3-1/2" X 0.135") OR 2 - 16d COMMON (3-1/2" X 0.162") OR 4 - 3" 0.131" NAILS	3 EACH 16" O.C. FACE NAIL 2 EACH 16" O.C. FACE NAIL 4 EACH 16" O.C. FACE NAIL
16	TOP OR BOTTOM PLATE TO STUD	4 - 8d BOX (2-1/2" X 0.113") OR 3 - 16d BOX (3-1/2" x 0.135") OR 4 - 8d COMMON (2-1/2" X 0.131") OR 4 - 10d BOX (3" X 0.128") OR 4 - 3" X 0.131" NAILS	TOE NAIL
		3 - 16d BOX (3-1/2" x 0.135") OR 2 - 16d COMMON (3-1/2" X 0.162") OR 3 - 10d BOX (3" X 0.128") OR 3 - 3" X 0.131" NAILS	END NAIL
17	TOP PLATES, LAPS AT CORNERS AND INTERSECTIONS	3- 10d BOX (3" x 0.128") OR 2 - 16d COMMON (3-1/2" X 0.162") OR 3 - 3" x 0.131" NAILS	FACE NAIL
18	1" BRACE TO EACH STUD AND PLATE	3 - 8d BOX (2-1/2" X 0.113") OR 2 - 8d COMMON (2-1/2" x 0.131") OR 2 - 10d BOX (3" X 0.128") OR 2 STAPLES 1-3/4"	FACE NAIL
19	1" X 6" SHEATHING TO EACH BEARING	3 - 8d BOX (2-1/2" X 0.113") OR 2 - 8d COMMON (2-1/2" x 0.131") OR 2 - 10d BOX (3" X 0.128") OR 2 STAPLES, 1" CROWN, 16 GA, 1-3/4" LONG	FACE NAIL
20	1" X 8" AND WIDER SHEATHING TO EACH BEARING	3 - 8d BOX (2-1/2" X 0.113") OR 3 - 8d COMMON (2-1/2" x 0.131") OR 3 - 10d BOX (3" X 0.128") OR 3 STAPLES, 1" CROWN, 16 GA, 1-3/4" LONG WIDER THAN 1" X 8"	FACE NAIL
		4 - 8d BOX (2-1/2" X 0.113") OR 3 - 8d COMMON (2-1/2" x 0.131") OR 3 - 10d BOX (3" X 0.128") OR 4 STAPLES, 1" CROWN, 16 GA, 1-3/4" LONG FLOOR	
21	JOIST TO SILL, TOP PLATE OR GIRDER	4 - 8d BOX (2-1/2" X 0.113") OR 3 - 8d COMMON (2-1/2" X 0.131") OR 3 - 10d BOX (3" x 0.128") 3 - 3" X 0.131" NAILS	TOE NAIL
22	RIM JOIST, BAND JOIST, OR BLOCKING TO SILL OR TOP	8d BOX (2-1/2" X 0.113") 8d COMMON (2-1/2" X 0.131") OR	4" O.C. TOE NAIL
22	PLATE (ROOF APPLICATIONS ALSO)	10d BOX (3" X 0.128") OR 3" x 0.131" NAILS 3- 8d BOX (2-1/2" X 0.113") OR	6" O.C. TOE NAIL
23	1" X 6" SUBFLOOR OR LESS TO EACH JOIST	2 - 8d COMMON (2-1/2" X 0.131") OR 3 - 10d BOX (3" X 0.128") OR 2 STAPLES, 1" CROWN, 16 GA, 1-3/4" LONG	FACE NAIL
24	2" SUBFLOOR TO JOIST OR GIRDER	3 - 16d BOX (3-1/2" X 0.135") OR 2 - 16d COMMON (3-1/2" X 0.162")	BLIND AND FACE NAIL
25	2" PLANKS (PLAN & BEAM - FLOOR & ROOF)	3 - 16d BOX (3-1/2" X 0.135") OR 2 - 16d COMMON (3-1/2" X 0.162")	AT EACH BEARING, FACE NAIL
26	BAND OR RIM JOIST TO JOIST	3- 16d COMMON (3-1/2" X 0.162") OR 4 - 10d BOX (3" X 0.128") OR 4 - 3" X 0.131" NAILS OR 4 - 3" X 14 GA STAPLES, 7/16" CROWN	END NAIL
		20d COMMON (4" X 0.192") OR	NAIL EACH LAYER AS FOLLOWS: 32" O.C. AT TOP AND BOTTOM AND STAGGERED
27	BUILT-UP GIRDERS AND BEAMS, 2" LUMBER LAYERS	10d BOX (3" X 0.128") OR 3" X 0.131" NAILS	24" O.C. FACE NAIL AT TOP AND BOTTOM STAGGERED ON OPPOSITE SIDES
		AND: 2 - 20d COMMON (4" X 0.192") OR 3 - 10d BOX (3" X 0.128") OR 3 - 3" X 0.131" NAILS	FACE NAIL AT ENDS AND AT EACH SPLICE
28	LEDGER STRIP SUPPORTING JOISTS OR RAFTERS	4 - 16d BOX (3-1/2" X 0.135") OR 3 - 16d COMMON (3-1/2" x 0.162") OR 4 - 10d BOX (3" X 0.128") OR	AT EACH JOIST OR RAFTER, FACE NAIL


29	BRIDGING TO JOIST	2 - 10d BOX (3" X 0.128") OR 2- 8d COMMON (2-1/2" X 0.131"; OR 2- 3" X 0.131") NAILS	EACH END, TOE NAIL	
			SPACING (OF FASTENERS
ITEM	DESCRIPTION OF BUILDING ELEMENTS	NUMBER & TYPE OF FASTENER a,b,c	EDGES (INCHES) h	INTERMEDIATE SUPPORTS ^{c,e} (INCHES
WOO	D STRUCTURAL PANELS, SUBFLOOR, ROOF AND INTERIOR WAL R602.3(3) FOR WOOD STRUCTURA	L SHEATHING TO FRAMING AND PARTICLEBOAI AL PANEL EXTERIOR WALL SHEATHING TO WALI		FRAMING [SEE TABLE
30	3/8" - 1/2"	6d COMMON (2" X 0.113") NAIL (SUBFLOOR, WALL) ⁱ 8d COMMON (2-1/2" X 0.131") NAIL (ROOF)	6	12 ^f
31	19/32" - 1"	8d COMMON (2-1/2" X 0.131"); OR RSRS-01; (2-3/8" X 0.113") NAIL (ROOF) ^j	6	12 ^f
32	1-1/8" - 1-1/4"	10d COMMON (3" X 0.148") NAIL OR 8d (2-1/2" X 0.131") DEFORMED NAIL	6	12
	(OTHER WALL SHEATHING ^g		
33	1/2" STRUCTURAL CELLULOSIC FIBERBOARD SHEATHING	1-1/2" GALVANIZED ROOFING NAIL, 7/16" HEAD DIAMETER, OR 1-1/4" LONG 16 GA. STAPLE WITH 7/16" OR 1" CROWN	3	6
34	25/32" STRUCTURAL CELLULOSIC FIBERBOARD SHEATHING	1-3/4" GALVANIZED ROOFING NAIL, 7/16" HEAD DIAMETER, OR 1-1/2" LONG 16 GA. STAPLE WITH 7/16" OR 1" CROWN	3	6
35	1/2" GYPSUM SHEATHING ^d	1-1/2" GALVANIZED ROOFING NAIL, STAPLE GALVANIZED, 1-1/2" LONG; 1-1/4" SCREWS, TYPE W OR S	7	7
36	5/8" GYPSUM SHEATHING ^d	1-3/4" GALVANIZED ROOFING NAIL, STAPLE GALVANIZED, 1-5/8" LONG; 1-5/8" SCREWS, TYPE W OR S	7	7
	WOOD STRUCTURAL PANELS, C	COMBINATION SUBFLOOR UNDERLAYMENT TO	FRAMING	
37	3/4" AND LESS	6d DEFORMED (2" X 0.120") NAIL OR 8d COMMON (2-1/2" X 0.131") NAIL	6	12
38	7/8" - 1"	8d COMMON (2-1/2" X 0.131") NAIL OR 8d DEFORMED (2-1/2" X 0.120") NAIL	6	12
39	1-1/8" - 1-1/4"	10d COMMON (3" X 0.148") NAIL OR 8d DEFORMED (2-1/2" X 0.120") NAIL	6	12

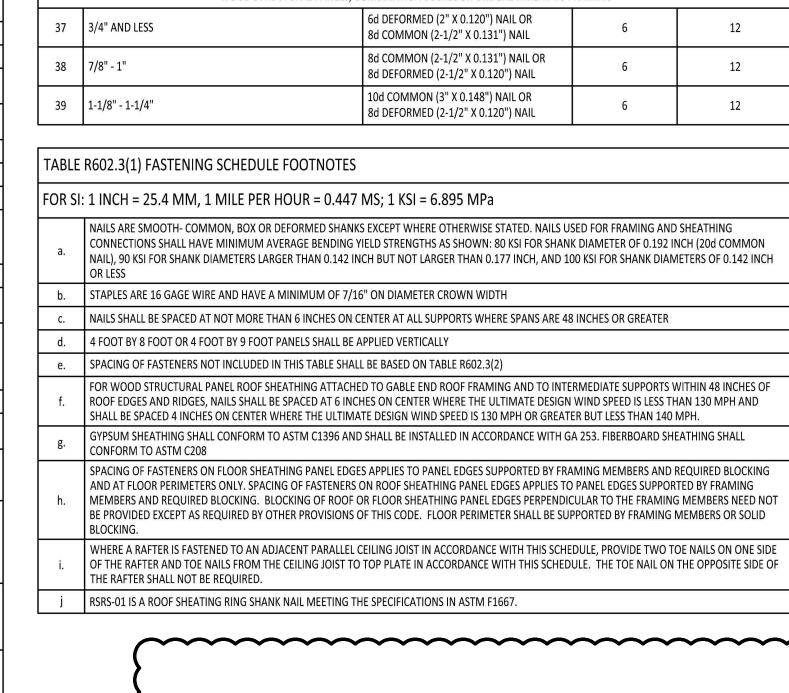



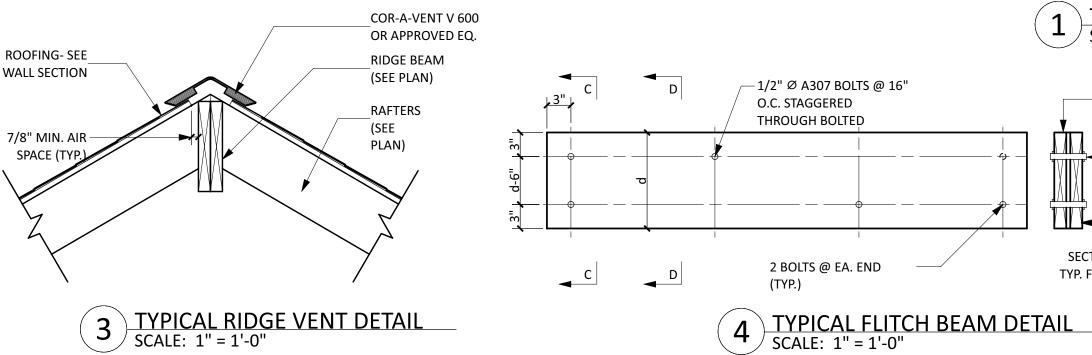

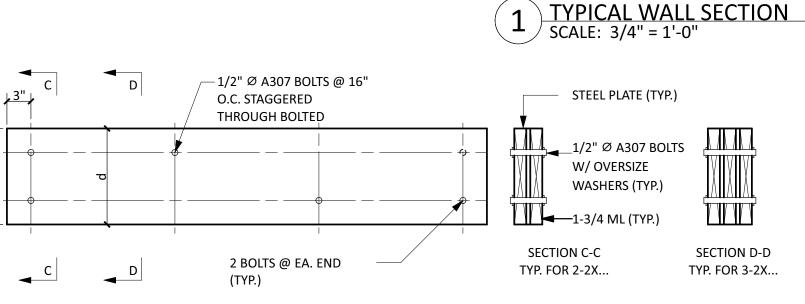

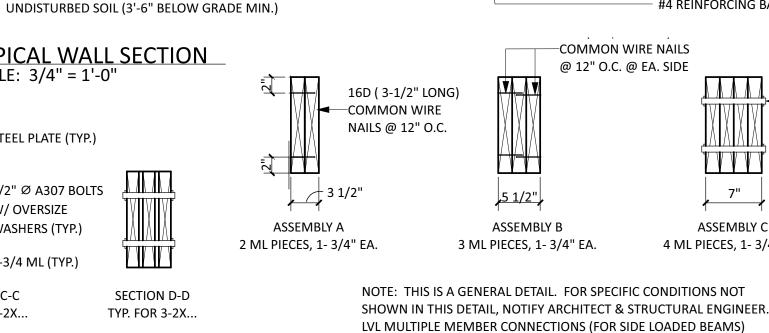

—COMMON WIRE NAILS @ 12" O.C. @ EA. SIDE 16D (3-1/2" LONG) ASSEMBLY B 3 ML PIECES, 1- 3/4" EA.

5 TYPICAL MULTIPLE LVL DETAIL SCALE: 1" = 1'-0"

5/8" Ø A307 BOLTS W/ **OVERSIZE** WASHERS (TYP.) ASSEMBLY C 4 ML PIECES, 1- 3/4" EA.

FIBERGLASS SHINGLE ROOFING OVE3 #30 FELT PAPER, DOUBLE FIRST COURSE- INSTALL AS PER

5/8" APA RATED PLYWOOD SHEATHING 32/16,

RAFTERS- SEE FLOOR PLAN FOR SIZE AND SPACING

PROVIDE ICE AND WATERSHIELD UNDERLAYMENT

PRE-FINISHED SEAMLESS ALUMINUM GUTTERS &

A MINIMUM OF 30" UP THE ROOF SLOPE FROM

MANUFACTURER'S SPECIFICATIONS

'SIMPSON' H2.5 @ EVERY RAFTER

VINYL OR ALUMINUM SOFFIT WITH

OVERHANG- SEE ELEVATIONS

CONTINUOUS SOFFIT VENT & INSECT SCREEN

FRIEZE BOARD. SEE ELEVATION NOTES FOR SIZE

2 X 6 HORIZONTAL CAT @ 4'-0" O.C. MAX. VERTICALLY

SIDING TO BE SELECTED BY OWNER & PROVIDED

'TYVEK' BUILDING WRAP (TAPE AT SEAMS) OVER

& INSTALLED BY G.C. SEE ELEVATION NOTES.

1/2" APA RATED PLYWOOD SHEATHING

32/16,EXTERIOR OR 1/2" OSB EXTERIOR

PROVIDE 2 X RIM BOARD- MATCH JOIST SIZE

PROVIDE 2 X RIM BOARD- MATCH JOIST SIZE

SILL - (2) 2 X 6 'ACQ' PRESSURE TREATED SILL PLATE

ON TERMITE SHIELD OVER FIBERGLASS SILL SEALER

1/2" DIAMETER X 18" HEADED ANCHOR BOLTS @ 48"

O.C. MIN. 24" FROM EVERY CORNER & MIN. 2 PER SILL PIECE (MIN. 15" EMBEDMENT). SET LEVEL & SECURE

TO TOP OF FOUNDATION WALL ON BED OF SEALANT

OR INSULATION. FILL TOP TWO COURSES OF BLOCK

"DUR-O-WALL" HORIZONTAL REINFORCING EVERY

PROVIDE 'TUFF-N-DRI' WATERPROOFING W/ 'WARM-N-DRI'

DRAINAGE & INSULATING BOARD OR APPROVED EQUAL OVER

NEW FOUNDATION WALL BELOW GRADE OVER 1/2" CEMENT

PARGING & CONNECT TO PERFORATED FOOTING DRAIN

- 4" DIAMETER PERFORATED FOOTING DRAIN IN GRAVEL BED- CONNECT TO DRAINAGE SYSTEM IF ONE EXISTS

ALL SECTIONS OF REBAR 20'-0" OR MORE IN LENGTH (ONE CONTINUOUS PIECE OF MANY PIECES TIED TOGETHER) SHALL BE BONDED TO THE GROUNDING ELECTRODE SYSTEM IN ACCORDANCE WITH THE

THE GROUNDING CLAMP SHALL BE INSTALLED PRIOR

NATIONAL ELECTRIC CODE, SECTION 250-70

MIN. 3" CONCRETE COVER AT REINFORCING

TO POURING THE FOUNDATION

#4 REINFORCING BARS @ 24" O.C.

(TYPICAL) - INSTALL AS PER MANUFACTURERS

RECOMMENDATIONS BY A CERTIFIED INSTALLER

SOLID WITH PEA GRAVEL CONCRETE

OTHER BLOCK COURSE

#5 REBAR @ 32" O.C.

PLASTER COVE

FINISH GRADE- SLOPE AWAY FROM HOUSE

CONCRETE BLOCK. SEE PLAN FOR SIZE

R-21 FIBERGLASS BATT INSULATION WITH VAPOR BARRIER

EXTERIOR

THE WALL LINE

1 X FASCIA BOARD

AT EVERY STUD

SHEATHING

(2) 2 X 6 TOP PLATE (TYP.)

LEADERS

METAL DRIP EDGE (TYP.)

ELEVATION

2 X 6 PLATE

(2) 2 X 6 TOP PLATE (TYP.)

BARRIER

SECOND FLOOR

FLOOR CONSTRUCTION:

GLUED AND SCREWED

SIZE & SPACING

FIRST FLOOR

FLOOR CONSTRUCTION:

GLUED AND SCREWED

UNFINISHED BASEMENT

BASEMENT SLAB:

FOUNDATION NOTES

#5 DOWELS @ 32" O.C. MAX W/ 30" VERTICAL

LEGS & 12" HORIZONTAL LEGS - FILL BOTTOM

CONCRETE SLAB ON COMPACTED GRAVEL ON

4" DIAMETER PERFORATED INTERIOR

FOOTING DRAIN. CONNECT TO SUMP PUMP

CONTINUOUS CONCRETE FOOTING W/ (3) #5

CONTINUOUS REINFORCING BARS OVER

W/ 1/2" FIBER FORM BOARD AND SEALANT. SEE

UNDISTURBED SOIL. SEPARATE SLAB END FROM WALL

- X ----- X

(3) COURSES WITH PEA GRAVEL CONCRETE

SIZE & SPACING

SEE PROJECT SPECIFICATIONS

3/4" PLYWOOD SUBFLOOR

R-38 FIBERGLASS BATT INSULATION WITH VAPOR BARRIER -

GYPSUM BOARD. SEE PROJECT SPECIFICATIONS FOR SIZE & TYPE

CEILING JOISTS- SEE PLAN FOR SIZE & SPACING

GYPSUM BOARD ON 2 X 6 WOOD STUDS @ 16" O.C.

R-21 FIBERGLASS BATT INSULATION WITH VAPOR

FLOOR FINISH AS PER SPECIFICATIONS OVER 3/4" APA RATED STURD-I-FLOOR, 24" O.C.,

EXPOSURE I, T & G PLYWOOD SUBFLOOR,

GYPSUM BOARD ON 2 X 6 WOOD STUDS

@ 16" O.C. SEE PROJECT SPECIFICATIONS

FLOOR FINISH AS PER SPECIFICATIONS OVER

3/4" APA RATED STURD-I-FLOOR, 24" O.C., EXPOSURE I, T & G PLYWOOD SUBFLOOR,

FLOOR JOISTS- SEE PLAN FOR JOIST

FLOOR JOISTS- SEE PLAN FOR JOIST

NOTE: 7" WIDE BEAMS MAY ONLY BE SIDE-LOADED WHEN LOADS ARE APPLIED TO BOTH SIDES OF THE MEMBERS (TO MINIMIZE ROTATION)

908.208.6085 299 barrow street #32 jersey city, nj 07302 theodorabdesigns.com

theodora boyadjis, RA, LEED AP NJ: 21Al01985000 NY: 039265

CONSULTANTS:

05.27.2021 CLIENT MEETING **CLIENT MEETING** 06.14.2021 ISSUE FOR BID 06.29.2021 **CLIENT MEETING** 09.10.2021 **CLIENT REVIEW** 10.08.2021 PERMIT SET 10.21.2021 **ISSUE FOR PERMIT** 11.08.2021 **ISSUE FOR PERMIT** 01.28.2021 REVISION


JOHNSON/ZIMMERMAN RESIDENCE 54 MYRTLE AVENUE METUCHEN NJ WALL SECTION, DETAILS,

REVISION

NAILING SCHEDULE

DATE: 05.10.2021 DRAWN BY: SP SCALE: AS NOTED CHECKED BY: TB

COPYRIGHT 2021. theodora boyadjis designs, Ilc. ALL RIGHTS RESERVED. ALL DESIGNS AND CONCEPTS SHOWN ON DRAWINGS ARE PROPERTY LOCATION, COPIED, SOLD OR SHARED WITH ANY PERSONS, FIRMS OR CORPORATIONS WITHOUT EXPRESSED WRITTEN PERMISSION. | PROJ. NO.: John21001 9 SHEET OF 12

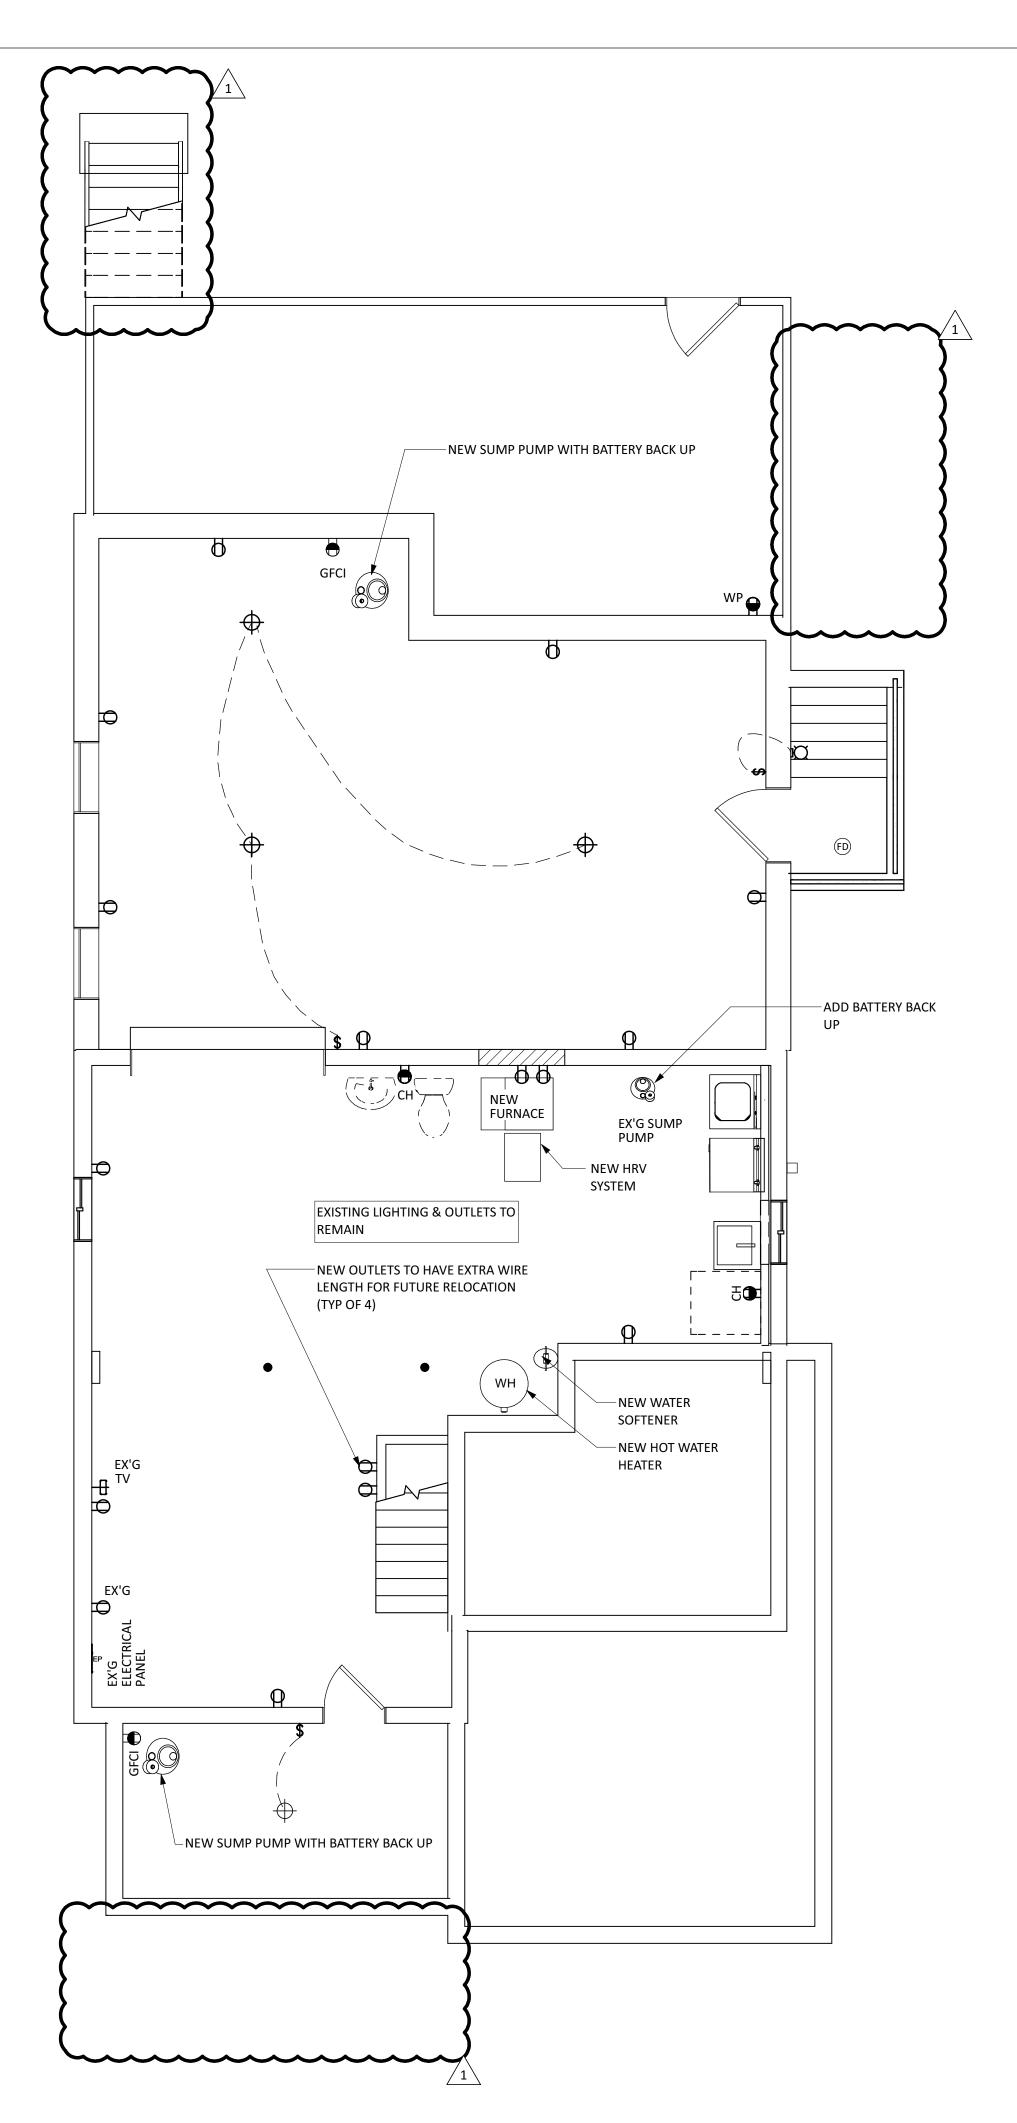

ELECTRICAL NOTES:

- 1. ALL INTERIOR WIRING TO BE COPPER ROMEX NM WITH GROUND. ALL NEW WIRING IN ACCORDANCE WITH N.E.C.
- 2. NUMBER OF OUTLETS ON BRANCH CIRCUITS: 7 ON A 15 AMP, 8 ON A 20 AMP
- 3. WIRING TO BE SIZED AS FOLLOWS:
- 15A #14
- 20A #12 30A - #10

60A - #6

- 45A #8
- 4. ALL RECEPTACLES TO BE GROUNDED TYPE.
- 5. BASE RECEPTACLES TO BE 1'-2" ABOVE FINISHED FLOOR, MEASURED FROM CENTER (UNLESS OTHERWISE NOTED).
- 6. FANS IN ROOMS THAT LACK NATURAL VENTILATION SHALL BE SIZED TO EXPEL A MINIMUM OF 2 CFM PER SQUARE FOOT OF ROOM. FANS IN TOILET ROOMS THAT LACK NATURAL VENTILATION SHALL BE SIZED TO EXPEL AT LEAST 70 CFM.
- 7. ALL FIXTURES SHALL BE SUPPLIED AND INSTALLED BY THE GENERAL CONTRACTOR UNLESS OTHERWISE SPECIFIED.
- 8. GENERAL CONTRACTOR SHALL BE RESPONSIBLE FOR ALL NEW APPLIANCE CONNECTIONS. PROVIDE NEW CIRCUITS AS REQUIRED.
- 9. INVESTIGATE EXISTING ELECTRICAL SERVICE. UPGRADE TO NEW 200 AMP ELECTRICAL SERVICE WITH NEW 40 POLE PANEL.
- 10. SERVICE CABLE TO BE SIZED AS REQUIRED AND INSTALLED IN ACCORDANCE WITH THE UTILITY COMPANY'S REQUIREMENTS.
- 11. SWITCHES TO BE ZOOZ Z-WAVE PLUS DIMMER TOGGLE (ZEN23) OR APPROVED EQUAL COORDINATE WITH OWNER FOR SMART SWITCH SYSTEM REQUIREMENTS.

KITCHEN ELECTRICAL NOTES:

- 12. LOCATIONS OF OUTLETS AND SWITCHES TO BE CONFIRMED WITH OWNER AND KITCHEN DESIGNER PRIOR TO ROUGH WIRING
- 13. ALL KITCHEN RECEPTACLES AT COUNTERS TO BE GFI & COUNTER HEIGHT
- 14. COORDINATE COMPUTER, PHONE, AND CABLE CONNECTIONS WITH ARCHITECT AND OWNER PRIOR TO ROUGH WIRING

ATTIC NOTES:

- PROVIDE THE FOLLOWING IN THE ATTIC:
- 15. COORDINATE ELECTRICAL REQUIREMENTS FOR MECHANICAL EQUIPMENT WITH ELECTRICAL CONTRACTOR.
- 16. (1) SMOKE/ CARBON MONOXIDE DETECTOR COMBINATION
- 17. (3) LED UTILITY LIGHTS WITH SWITCH. COORDINATE W/ OWNER FOR EXACT LOCATION
- 18. (3) DUPLEX RECEPTACLES. COORDINATE W/ OWNER FOR EXACT LOCATION

HVAC NOTE:

1. QUANTITY AND LOCATIONS FOR HVAC SUPPLIES, RETURNS, THERMOSTATS, AND/OR RADIATORS ARE PROPOSED BASED ON AESTHETICS. HVAC SUBCONTRACTOR SHALL SCHEDULE A WALKTHROUGH WITH THE OWNER & ARCHITECT TO VERIFY QUANTITY AND LOCATIONS OF PIPES, DUCTS, SUPPLIES, RETURNS, THERMOSTATS, AND/OR RADIATORS PRIOR TO ROUGHING DUCTWORK. HVAC SUBCONTRACTOR SHALL EVALUATE PROPOSED LOCATIONS AND QUANTITY OF SUPPLIES AND RETURNS FOR EFFICIENCY.

MECHANICAL EQUIPMENT NOTE:

1. G.C. TO CONSULT WITH ARCHITECT TO DETERMINE THE BEST LOCATION FOR NEW HVAC UNITS, HOT WATER HEATERS, BOILERS, ELECTRICAL PANELS, GAS & WATER SERVICES, ETC.

SOLAR PANEL NOTES:

1. COORDINATE WITH SOLAR PANEL VENDOR/ DESIGNER & PROVIDE ANY ELECTRICAL REQUIREMENTS FOR FUTURE INSTALLATION.


CARBON MONOXIDE ALARM NOTES:

- 1. CARBON MONOXIDE DETECTOR ALARMS SHALL BE PROVIDED IN THE FOLLOWING LOCATIONS: ONE IN THE IMMEDIATE VICINITY OF ALL SLEEPING ROOMS IN BUILDINGS THAT CONTAIN FUEL-BURNING APPLIANCES OR HAVE ATTACHED GARAGES. IF A FUEL BURNING APPLIANCE IS LOCATED WITHIN A BEDROOM OR ITS ATTACHED BATHROOM, A CARBON MONOXIDE ALARM SHALL BE INSTALLED WITHIN THE BEDROOM.
- 1.1. THE ALARM MAY BE LOCATED ON THE WALL, CEILING OR OTHER LOCATIONS AS SPECIFIED IN THE MANUFACTURER'S INSTALLATION INSTRUCTIONS.
- 1.2. THE DEVICE IS REQUIRED TO BE SUPPORTED INDEPENDENTLY OF ITS ATTACHMENT TO WIRES.
- 1.3. FOR ALARMS INSTALLED IN THE VICINITY OF SLEEPING ROOMS, THE ALARM NOTIFICATION APPLIANCE IS REQUIRED TO BE CLEARLY AUDIBLE IN ALL BEDROOMS OVER BACKGROUND NOISE LEVELS AND WITHIN ALL INTERVENING DOORS CLOSED, WITH A MINIMUM RATING OF 85DBA AT 10 FEET (3M). IF THE ALARM IS INTENDED TO NOTIFY OCCUPANTS IN THE SAME ROOM, THE SOUND PRESSURE LEVEL IS PERMITTED TO BE 75DBA AT 10 FEET.
- 2. THE CARBON MONOXIDE DETECTOR ALARM IS REQUIRED TO BE MANUFACTURED, LISTED, AND LABELED IN ACCORDANCE WITH UL 2034 ENTITLED, "SINGLE" AND UL 217 "COMBINATION CARBON MONOXIDE/ SMOKE ALARMS." EACH DEVICE SHALL HAVE A LABEL INDICATING THAT IT MEETS THIS REQUIREMENT.
- 3. THE POWER SOURCE IS REQUIRED TO FROM THE BUILDING WIRING WHERE SUCH WIRING IS SERVED FROM A COMMERCIAL SOURCE. ALARMS SHALL RECEIVE POWER FROM A BATTERY WHEN THE PRIMARY POWER SOURCE IS INTERRUPTED. WIRING SHALL BE PERMANENT AND WITHOUT A DISCONNECTING SWITCH OTHER THAN THOSE REQUIRED FOR OVERCURRENT PROTECTION.
- 3.1. THE ALARM SHALL BE PERMITTED TO BE BATTERY OPERATED WHERE INSTALLED IN BUILDINGS WITHOUT COMMERCIAL POWER.
- 4. THE RESIDENCE REQUIRES CARBON MONOXIDE DETECTOR ALARMS. CONTRACTOR TO CONFIRM LOCATION OF ALARMS WITH LOCAL CODE ENFORCEMENT OFFICIAL PRIOR TO
- 5. COMBINATION SMOKE DETECTOR AND CARBON MONOXIDE ALARMS THAT MEET THE ABOVE REQUIREMENTS MAY BE SUBSTITUTED.
- 6. REFER TO IRC 2018 R315 FOR ADDITIONAL REQUIREMENTS/ EXCEPTIONS.

SMOKE DETECTOR ALARM NOTES:

- 1. SMOKE DETECTOR ALARMS SHALL BE PROVIDED IN THE FOLLOWING LOCATIONS: ONE IN EVERY SLEEPING ROOM, ONE IN THE IMMEDIATE VICINITY EVERY SLEEPING ROOM DOOR, ONE ON EACH STORY OF THE DWELLING, INCLUDING BASEMENTS AND HABITABLE ATTICS, AND ONE WITHIN 3 FEET FROM THE DOOR OF A BATHROOM THAT CONTAINS A BATHTUB OR SHOWER.
- 2. SMOKE DETECTOR ALARMS SHALL NOT BE INSTALLED IN THE VICINITY OF A PERMANENT COOKING APPLIANCE AS FOLLOWS: IONIZATION ALARM: WITHIN 20 FEET, IONIZATION ALARM W/ AN ALARM SILENCING SWITCH: WITHIN 10 FEET, PHOTOELECTRIC ALARM: WITHIN 6 FEET.
- 3. WITHIN EACH INDIVIDUAL DWELLING UNIT, THE DEVICES ARE REQUIRED TO BE INTERCONNECTED IN SUCH A MANNER THAT THE ACTUATION OF ONE ALARM WILL ACTIVATE ALL OF THE ALARMS IN THE UNIT. PHYSICAL INTERCONNECTION SHALL NOT BE REQUIRED WHERE LISTED WIRELESS ALARMS ARE INSTALLED AND ALL ALARMS SOUND UPON ACTIVATION OF ONE ALARM.
- 4. THE POWER SOURCE IS REQUIRED TO FROM THE BUILDING WIRING WHERE SUCH WIRING IS SERVED FROM A COMMERCIAL SOURCE. ALARMS SHALL RECEIVE POWER FROM A BATTERY WHEN THE PRIMARY POWER SOURCE IS INTERRUPTED. WIRING SHALL BE PERMANENT AND WITHOUT A DISCONNECTING SWITCH OTHER THAN THOSE REQUIRED FOR OVERCURRENT PROTECTION.
- 5. THE RESIDENCE REQUIRES SMOKE DETECTOR ALARMS. CONTRACTOR TO CONFIRM LOCATION OF ALARMS WITH LOCAL CODE ENFORCEMENT OFFICIAL PRIOR TO WIRING.
- 6. COMBINATION SMOKE DETECTOR AND CARBON MONOXIDE ALARMS THAT MEET THE ABOVE REQUIREMENTS MAY BE SUBSTITUTED.
- 7. REFER TO IRC 2018 R314 FOR ADDITIONAL REQUIREMENTS/ EXCEPTIONS.

ELEC	TRICAL SYMBOLS		
SYMBOL	DESCRIPTION	SYMBOL	DESCRIPTION
Θ	EXHAUST FAN	\cap	HARDWIRE CONNECTION-
	PENDANT)	DEDICATE WHERE REQUIRED
\circ	RECESSED DOWNLIGHT	P	DUPLEX RECEPTACLE
\bigoplus	CEILING MOUNTED FIXTURE		FLOOR OUTLET
Q	WALL SCONCE		OVERHEAD OUTLET
	CHANDELIER LIGHT FIXTURE	 	QUADRAPLEX RECEPTACLE
	LED LIGHT FIXTURE (CL.)	Θ	GFCI OUTLET
	LED UTILITY LIGHT		LED UNDER CABINET LIGHTS
<u> </u>	FLOOD LIGHT	\$	SWITCH
C	CABLE TV RECEPTACLE	3	SWITCH- 3 WAY
\boxtimes	COMPUTER / DATA RECEPTACLE	D _{\$}	SWITCH- DIMMER
\bigcirc	HARDWIRED SMOKE DETECTOR WITH	т _{\$}	SWITCH- TIMER
SD	BATTERY BACKUP	WP	WATER PROOF
O CO/SD	CARBON MONOXIDE/ SMOKE DETECTOR	GFCI	GROUND FAULT CIRCUIT
—— EP	ELECTRICAL PANEL	ВВ	MOUNT IN BASEBOARD
	TV LOCATION:	IN CAB.	MOUNT IN CABINET
	-HDMI CONNECTION -QUAD OUTLET	СН	COUNTER HEIGHT
	-ETHERNET -CABLE	MS	MOTION SENSOR
∄ SC	SECURITY CAMERA	(SP)	CEILING SPEAKER

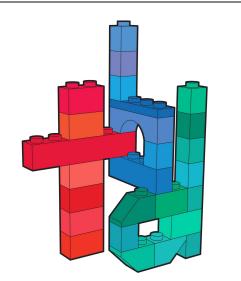

908.208.6085 299 barrow street #32 jersey city, nj 07302 theodorabdesigns.com 🖚

theodora boyadjis, RA, LEED AP NJ: 21AI01985000 NY: 039265

CONSULTANTS:


05.27.2021 CLIENT MEETING **CLIENT MEETING** 06.14.2021 **ISSUE FOR BID** 06.29.2021 **CLIENT MEETING** 09.10.2021 **CLIENT REVIEW** 10.08.2021 PERMIT SET **ISSUE FOR PERMIT ISSUE FOR PERMIT** REVISION REVISION


JOHNSON/ZIMMERMAN RESIDENCE 54 MYRTLE AVENUE METUCHEN NJ

BASEMENT/ FOUNDATION ELECTRICAL FLOOR PLAN, **NOTES**

DATE: 05.10.2021 DRAWN BY: SP SCALE: AS NOTED CHECKED BY: TB

BASEMENT/ FOUNDATION ELECTRICAL FLOOR PLAN SCALE: 1/4" =1[']-0"

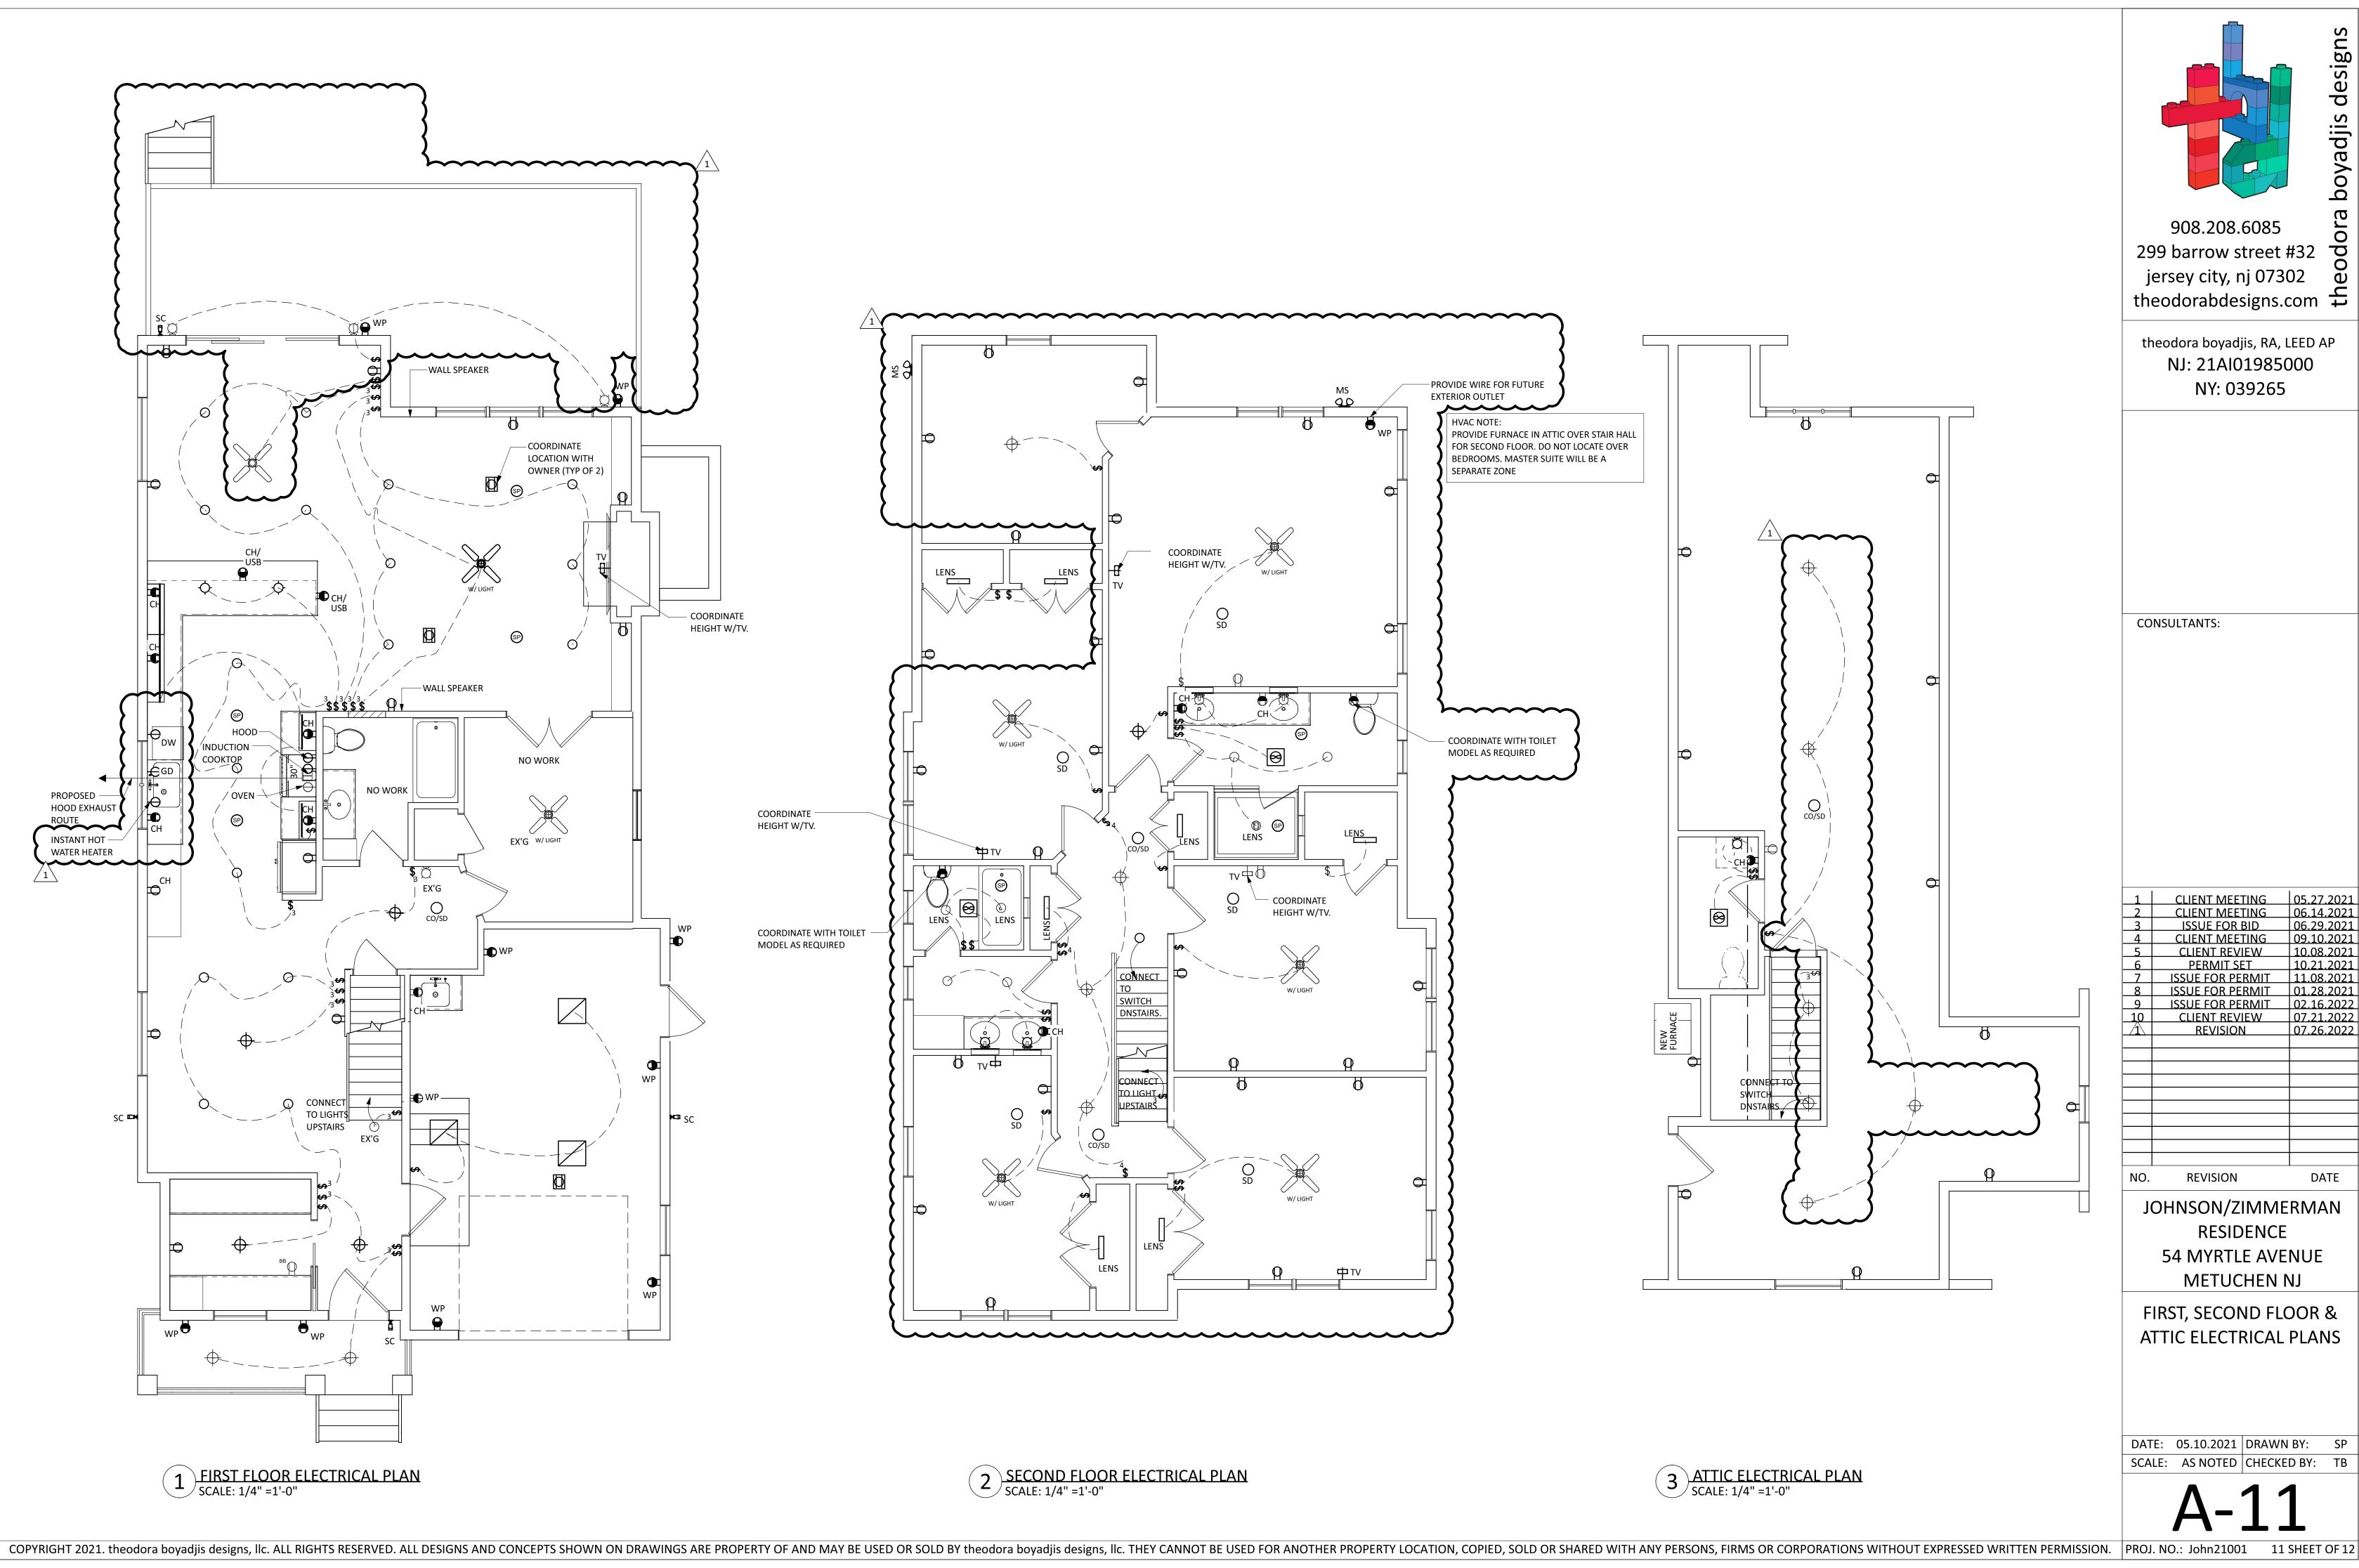

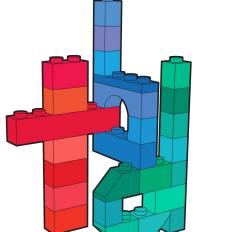

908.208.6085 908.208.6085
299 barrow street #32
jersey city, nj 07302
theodorabdesigns.com

theodora boyadjis, RA, LEED AP NJ: 21AI01985000 NY: 039265


1	CLIENT MEETING	05.27.2021
2	CLIENT MEETING	06.14.2021
3	ISSUE FOR BID	06.29.2021
4	CLIENT MEETING	09.10.2021
5	CLIENT REVIEW	10.08.2021
6	PERMIT SET	10.21.2021
7	ISSUE FOR PERMIT	11.08.2021
8	ISSUE FOR PERMIT	01.28.2021
9	ISSUE FOR PERMIT	02.16.2022
LO	CLIENT REVIEW	07.21.2022
1	REVISION	07.26.2022

JOHNSON/ZIMMERMAN RESIDENCE 54 MYRTLE AVENUE


FIRST, SECOND FLOOR &

ATTIC ELECTRICAL PLANS

DATE: 05.10.2021 DRAWN BY: SP SCALE: AS NOTED CHECKED BY: TB

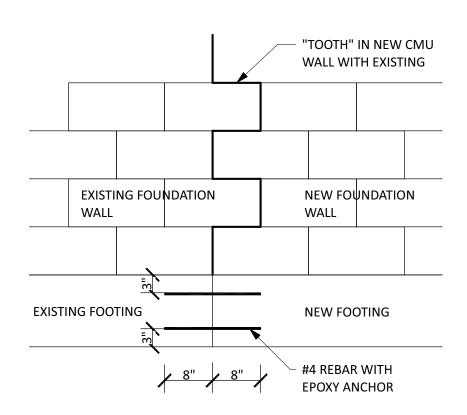

1 EX'G FOUNDATION TO NEW DETAIL SCALE: 3/4" =1'-0"

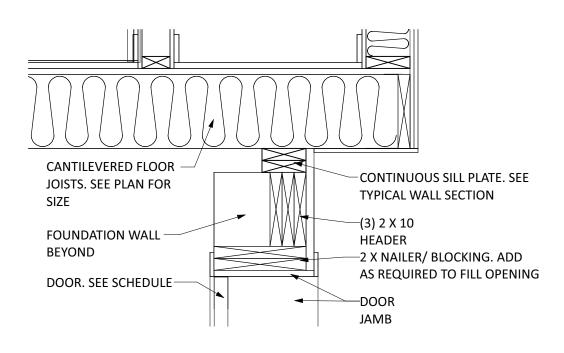


BASEMENT DOOR HEADER DETAIL
SCALE: 1" =1'-0"

OMIT PRONT STEPS FOUNDATION DETAIL SCALE: 2/4" = 41.0"

INTERIOR STAIR NOTE:

- 1. STAIN GRADE WOOD TREADS, POSTS & RAILS
- 2. PAINT GRADE WOOD RISERS, BALUSTERS & TRIM 3. RISE: 8" MAX
- 4. BASEMENT STEP TREAD: 11 + 1" NOSING (12" TOTAL) 5. ATTIC STAIR TREAD: 9" +1" NOSING (10" TOTAL)
- 6. VERIFY # OF RISERS PRIOR TO ORDERING
- 7. STAIR TO HAVE 6'-8" HEAD CLEARANCE THROUGHOUT ENTIRE RUN
- 8. PROVIDE A CONTINUOUS HANDRAIL ON ONE SIDE OF STAIR MIN. (4 OR MORE RISERS); HANDRAIL TO TERMINATE INTO WALL. SEE PROJECT SPECIFICATIONS FOR ADDITIONAL

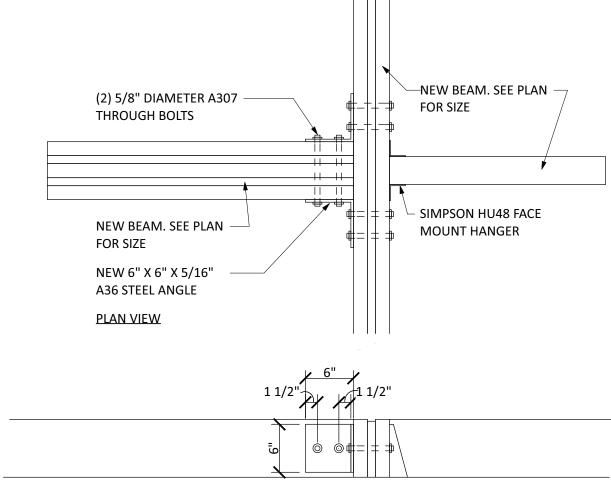

CROSS SECTION VIEW

3 FLITCH BEAM CONNECTION DETAIL SCALE: 1" =1'-0"



theodora boyadjis, RA, LEED AP NJ: 21AI01985000 NY: 039265

CONSULTANTS:

 1
 ISSUE FOR REVIEW
 12.20.2021

 8
 ISSUE FOR PERMIT
 01.28.2021

 1
 REVISION
 07.26.2022

REVISION JOHNSON/ZIMMERMAN RESIDENCE 54 MYRTLE AVENUE

METUCHEN NJ

FOUNDATION DETAILS, FLITCH BEAM DETAILS, **BUILDING SECTIONS**

DATE: 05.10.2021 DRAWN BY: SP SCALE: AS NOTED CHECKED BY: TB

COPYRIGHT 2021. theodora boyadjis designs, Ilc. ALL RIGHTS RESERVED. ALL DESIGNS AND CONCEPTS SHOWN ON DRAWINGS ARE PROPERTY LOCATION, COPIED, SOLD OR SHARED WITH ANY PERSONS, FIRMS OR CORPORATIONS WITHOUT EXPRESSED WRITTEN PERMISSION. PROJ. NO.: John21001 12 SHEET OF 12